


Section 31 Township 32 Range 11E

Well Number 1 Floyd

Company Morrow & Sons

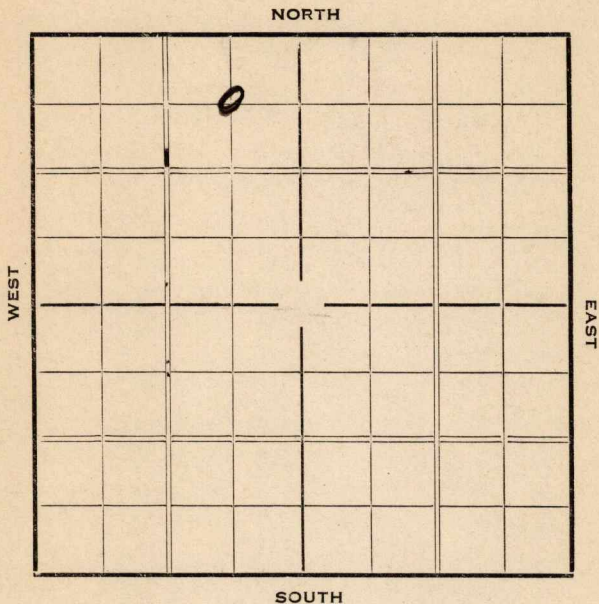

KANSAS

Chautauqua

Map No. Sec. 31 Twp. 32 R. 11E

Well No. 1 Floyd Farm


Morrow & Sons Company

..... 660 Ft. from N. Line

..... Ft. from S. Line

..... 660 Ft. from E. Line

..... Ft. from W. Line

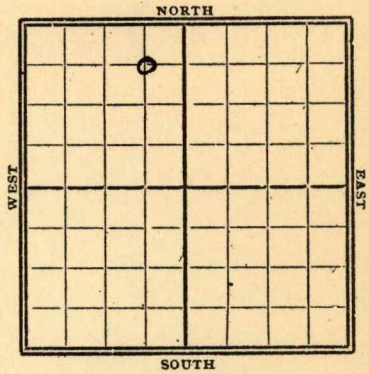

Date	REPORT
1936	
12/9	<u>Miss. L. 1975</u>
	5" @ 1975
	Pay 2010-22 T.D.
	Pump 7 bbls.
12/17	--
12/24	1000 acid. No test.
12/29	---
1937	
1/7	Drlg. 2050'.
1/14	" "
1/20	<u>Miss. 1975'. T. D. 2050'.</u>
	1000 acid. D & A
	ABANDONED

Map No. 4 Sec. 31 Twp. 32 R. 11E

Well No. 1 Floyd

Horrocks & Sons. Company

Contractor

SECTION PLAT

	0		

660 Ft. from N. Line

_____ Ft. from S. Line

660 Ft. from E. Line

_____ Ft. from W. Line

ABANDONED

Location _____

Rig up _____

Drilling and Remarks:

*Nov 1935.
1000 cu ft
D.H.*

RECORD

Cased _____ in., _____ ft.

Sand _____

Gas _____

Oil _____

Total Depth 2050

PRODUCTION

1st 24 hrs. Nat. _____

1st 24 hrs. after shot _____

Gas _____ Cu. Ft.

Dry Hole _____

Abandoned _____

Date

JAN 20 1937 19

S. J. LEWIS Scout

Chautauque **KANSAS**

Map No. 4 Sec. 31 Twp. 32 R. 11E

Well No. 1 Floyd

Morrow & Sons Company

Contractor

SECTION PLAT

	0		

660 Ft. from N. Line

_____ Ft. from S. Line

660 Ft. from E. Line

_____ Ft. from W. Line

FIRST REPORT

Location _____

Rig up _____

Drilling and Remarks:

*Mish 1925
5" C 1925
Log 2010-22. TD
Pump 7 1/2 in.*

RECORD

Cased _____ in., _____ ft.

Sand _____

Gas _____

Oil _____

Total Depth _____

PRODUCTION

1st 24 hrs. Nat. _____

1st 24 hrs. after shot _____

Gas _____ Cu. Ft.

Dry Hole _____

Abandoned _____

Date

DEC 9 1936 19

S. J. LEWIS Scout