

KANSAS

Barton


FORM 51 5M 4-41 PETROL

Section 18 Township 16 Range 11-W

Well No. 3 Scharzt

Company Solar Oil

NORTH Prusa Pool

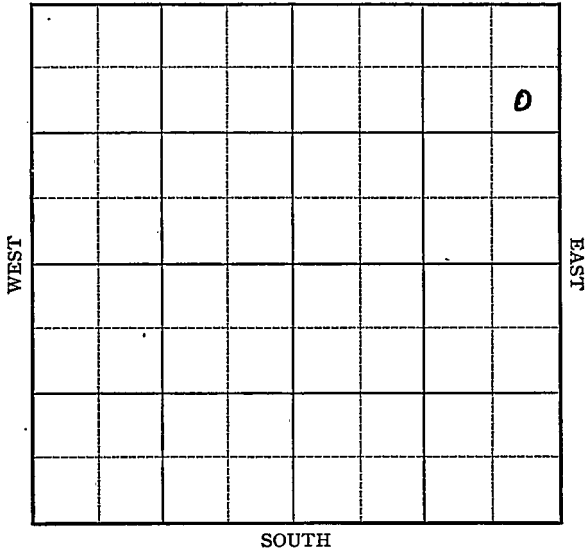

Sec. 18 Twp. 16 R. 11-W

Well No. #3 Scharztz Farm

Solar Oil Company


(Prusa)

990 Ft. from N. Line

_____ Ft. from S. Line

330 Ft. from E. Line

_____ Ft. from W. Line

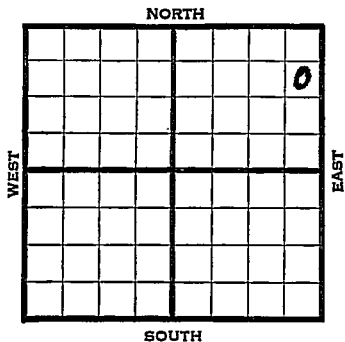

1941	REPORT
8/20	Location
8/28	8" - 234' WOC.
9/4	Topeka 2660' Lans. 3017'
	Drlg. 3054'
9/11	5" - 3235' Quartzite 3282'
	T.D. 3321' P.B.
9/18	43 shots 3169-78½' 5500 acid.
9/25	Pump 450 oil in 30 hours.
10/1	Lans. 3017'
	Quartzite 3282'
	T.D. 3321'
	P.B.
	43 shots 3169-78½'
	5500 acid.
	Potential 514 bbls., pump.
	43. Gravity
	COMPLETED

Map No. 55 Sec. 18 Twp. 16 R. 11WWell No. 3 Scharztz

Solar Oil

Company

FIRST REPORT

Contractor

SE NE NE

990 Ft. from N. Line

_____ Ft. from S. Line

330 Ft. from E. Line

_____ Ft. from W. Line

SECTION PLAT

PRUSA POOL

Location X

Rig up _____

Drilling and Remarks:

RECORD

Cased _____ in., _____ ft.

Sand _____

Gas _____

Oil _____

Total Depth _____

PRODUCTION

1st 24 hrs. Nat. _____

1st 24 hrs. after shot _____

Gas _____ Cu. Ft.

Dry Hole _____

Abandoned _____

Date

AUG 20 1941₁₉S. J. LEWIS Scout

Barton

KANSASMap No. H-55 Sec. 18 Twp. 16 R. 11WWell No. 3 SchartzSolar Oil CompanyCOMPLETED Contractor

SE NE NE

SECTION PLAT

990 Ft. from N. Line Ft. from S. Line330 Ft. from E. Line Ft. from W. Line

			e

PRUSA POOL

Location _____

Rig up _____

Drilling and Remarks:

Trans 3017
Quartzite 3282
PS
43 shot to 3165-78 1/2
5000 ac oil
Pump 514 PS
430 ac

RECORD

Cased _____ in., _____ ft.

Sand _____

Gas _____

Oil _____

Total Depth 3321

PRODUCTION

1st 24 hrs. Nat. _____

1st 24 hrs. after shot _____

Gas _____ Cu. Ft.

Dry Hole _____

Abandoned _____

Date

OCT 1 1941 19S. J. LEWIS Scout