KANSAS

FORM 51 5M 1-42 PETROL


Barton

Section 18 Township 16 Range 11-W

Well No. #4 Schartz

Company Solar Oil

Kraft Prusa Oil

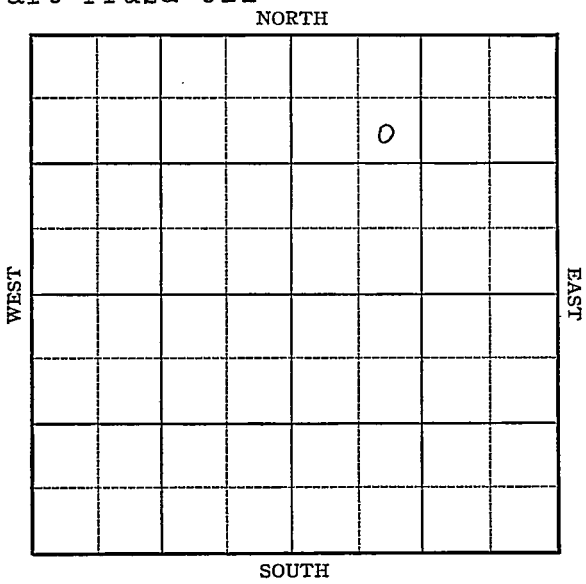

Form 252-A
5M 5-42 Petrol

KANSAS

Barton

Sec. 18 Twp. 16 R. 11-W.

Well No. #4 Schartz Farm

Solar Oil Company

Kraft Prusa oil


990 Ft. from N. Line

Ft. from S. Line

Ft. from E. Line

990 Ft. from W. Line

SE NW NE Elev. 1835

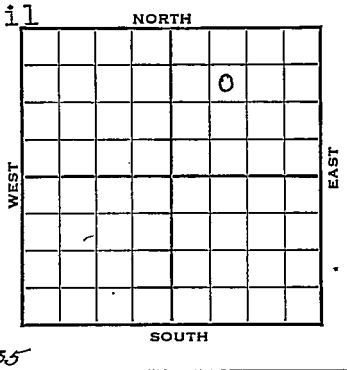

1942	REPORT
11/24	Location
12/2	8" @ 242 Drlg. 1790
12/9	Lans 2986 Drlg. 3220 SSO
12/16	Arb 3253 5" @ 3253 Drlg. 3263-2936 oil in 36 hrs.
12/22	Swab 40 bbls. oil per hr. 7 hrs.
12/29	Arb. 3253 5" @ 3253' T.D. 3268' Depth Pot. 1809' Gravity 43.6

COMPLETED

Form 26 200 Bks 5-42 Petrol

KANSAS Barton

Map No. 55 Sec. 18 Twp. 16 R. 11W

Well No. 4 Schartz

Solar Oil Company

FIRST REPORT Contractor

SE NW NE


990 Ft. from N. Line

_____ Ft. from S. Line

_____ Ft. from E. Line

990 Ft. from W. Line

SECTION PLAT

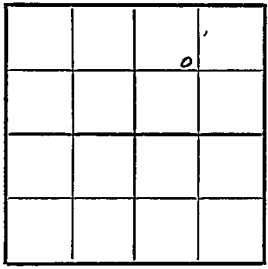

KRAFT PRUSA POOL

Location XXX

Rig up _____

Drilling and Remarks:

-

RECORD

Cased _____ in., _____ ft.

Sand _____

Gas _____

Oil _____

Total Depth _____

PRODUCTION

1st 24 hrs. Nat. _____

1st 24 hrs. after shot _____

Gas _____ Cu. Ft.

Dry Hole _____

Abandoned _____

Date

NOV 24 1942 19 S. J. LEWIS Scout

Form 26 200 Bks 5-42 Petrol

KANSAS

Barton

Map No. 55 Sec. 18 Twp. 16 R. 11W

Well No. 4 Schartz

Solar Oil Company

COMPLETED Contractor

SE NW NE


990 Ft. from N. Line

Ft. from S. Line

Ft. from E. Line

990 Ft. from W. Line

SECTION PLAT

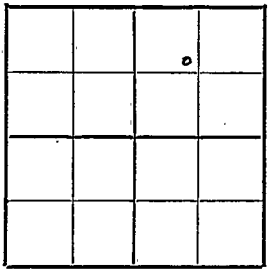

KRAFT PRUSA POOL

Location

Rig up

Drilling and Remarks:

Cr X 3253

5" @ 3253

Top Pay 1709

4 3/4 Gr

RECORD

Cased in., ft.

Sand

Gas

Oil

Total Depth 3268

PRODUCTION

1st 24 hrs. Nat.

1st 24 hrs. after shot

Gas Cu. Ft.

Dry Hole

Abandoned

Date

DEC 29 1942 19

S. J. LEWIS Scout