


Section 8 Township 32 Range 12 - E

Well Number 1 - Lagree

Company Craft

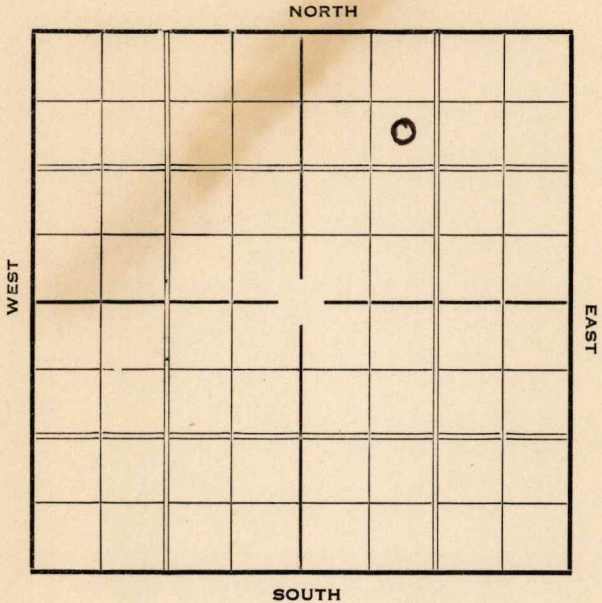

Sec. 8 Twp. 32 R. 12-E

Well No. #1 Lagree Farm


Craft Company

990 Ft. from N. Line

_____ Ft. from S. Line

_____ Ft. from E. Line

990 Ft. from W. Line

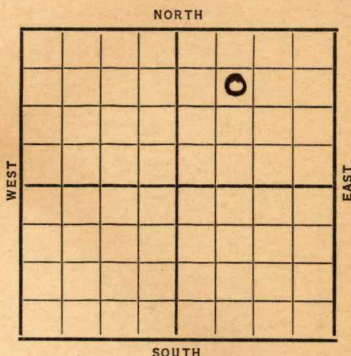

Date	REPORT
1937	
5/19	6" @ 1324'.
	Miss. 1600'.
	T.D. 1667'.
	U. R. 6".
5/28	" "
6/4	SD 1667'.
6/11	SD 1820'.
6/19	" "
6/25	T.D. 1853'. Rng. 5".
7/2	" " " "
7/9	" " " "
7/16	Drlg. 1904'.
7/23	5" @ 1898'. H.F.W. 1904'.
	Drlg. 2080'.
7/30	" "
8/6	" "
8/13	P.B. to 700'. Sand 665-87'.
	Est. 4 bbls. oil per day.
8/20	" " " " "
8/28	" " " " "

OVER

1937

9/3

Sil. 1904'. T.D. 2080' H.F.W.
Plug back.

9/10

" "

9/17

" "

9/22

Sil. 1904'.
T.D. 2080'.
4 bbls.

COMPLETED

KANSAS Chautauque

Map No. 4 Sec. 8 Twp. 32 R. 12E

Well No. 1 - Lagree

Craft Company

Contractor

FIRST REPORT

SECTION PLAT

990 Ft. from N. Line
____ Ft. from S. Line
____ Ft. from E. Line
990 Ft. from W. Line

		0	

Location _____

Rig up _____

Drilling and Remarks:

6" 1324
Miss 1600
T.D. 1667
U.R. 6"

RECORD

Cased _____ in., _____ ft.
Sand _____
Gas _____
Oil _____
Total Depth _____

PRODUCTION

1st 24 hrs. Nat. _____
1st 24 hrs. after shot _____
Gas _____ Cu. Ft.
Dry Hole _____
Abandoned _____

Date

MAY 19 1937 19

H. D. Hatfield Scout

KANSAS

Form 26-1M Bks 2-29

Chautauqua

Map No. 4 Sec. 8 Twp. 32 R. 12E

Well No. 1-Laguer

Craft

Company

Contractor

SECTION PLAT

990 Ft. from N. Line

Ft. from S. Line

Ft. from E. Line

990 Ft. from W. Line

		0	

COMPLETED

Location

Rig up

Drilling and Remarks:

4 bbls

RECORD

Cased in., ft.

Sand Sil 1904

Gas

Oil

Total Depth 2080

PRODUCTION

1st 24 hrs. Nat.

1st 24 hrs. after shot

Gas Cu. Ft.

Dry Hole

Abandoned

Date

SEP 22 1937 19

H. D. Hatfield Scout