

Map No. Kan Sec. 24 Twp. 32 R 4



Well No. 9 Wallace Farm
J.A. Sull et al Company

300 Ft. from N. Line

..... Ft. from S. Line

..... Ft. from E. Line

1020 Ft. from W. Line

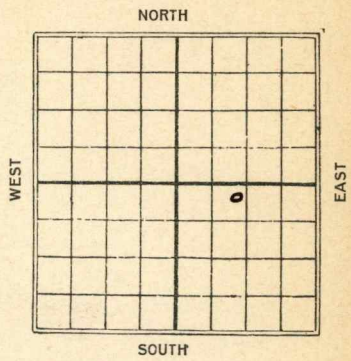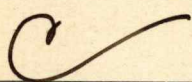

Date	REPORT
1925	
7/3	Drlg 1780
7/6	2080
7/17	Sp. 2334-75 sho oil H.F.W. 2374-2405. Drlg. 2535
7/24	St.R. 8" 2625'
7/31	v/h 6" to 2689' 2.0.
8/7	Tap 2960-3047-6" at 2962' shot 240 gts
	flowed 800 bbls at 24 hrs.
8/12	sand 2963-3047'-T.D. 240/450 bbls

Map No. 2 15000 Sec. 24 Twp. 32 R. 4

Well No. 9 Wallace

J. W. Hull & Co Company

Contractor

FIRST REPORTS

SECTION PLAT

300 Ft. from N. Line

----- Ft. from S. Line

----- Ft. from E. Line

1000 Ft. from W. Line

Location -----

Rig up -----

Drilling and Remarks:

dry 1780'

RECORD

Cased ----- in., ----- ft.

Sand -----

Gas -----

Oil -----

Total Depth -----

PRODUCTION

1st 24 hrs. Nat. -----

1st 24 hrs. after shot -----

Gas ----- Cu. Ft.

Dry Hole -----

Abandoned -----

Date

JUL 3

1925

CHAS. L. SHERWOOD

192

Scout

Cowley Co

Map No. 2 KANSAS Sec. 24 Twp. 32 R. 4

Well No. 9 Wallace

J. W. Hull & al Company

Contractor

COMPLETED

SECTION PLAT

300 Ft. from N. Line

----- Ft. from S. Line

----- Ft. from E. Line

1620 Ft. from W. Line

		o	

Location -----

Rig up -----

Drilling and Remarks:

240 / 450 bls.

RECORD

Cased 1 in., ----- ft.

Sand 2963-3047'

Gas -----

Oil -----

Total Depth 3047'

PRODUCTION

1st 24 hrs. Nat. -----

1st 24 hrs. after shot -----

Gas ----- Cu. Ft.

Dry Hole -----

Abandoned -----

Date

AUG 14 1925

192

CHAS. L. SHERWOOD

Scout