

SECTION 1 TOWNSHIP 33 RANGE 1 E

WELL NO. # 1 Matzen

COMPANY O. H. Parker

NORTH

14

WEST

EAST

SOUTH

0

Sumner

KANSAS

SEC. 1	TWP. 33	R. 1E
-----------	------------	----------

WELL NO. #1 Matzen FARM

COMPANY O. H. Parker

CONTRACTOR Capitt


WILDCAT

_____ Ft. from N. Line

_____ Ft. from S. Line

_____ Ft. from E. Line

_____ Ft. from W. Line

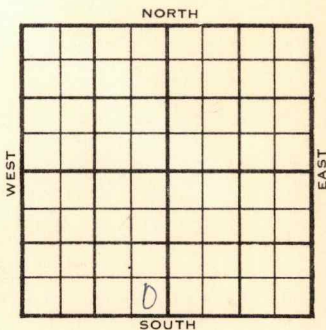

SE SE SW

1956	ELEVATION 1127'	REPORT
------	--------------------	--------

4-18 MIR

5-9 Comm. 4-20-56
8 5/8" @ 120 w/100

D&A

Stall 2454

KC 2871 2892

M.Chat 3467 3467

S. 3836

S.Sd 3842-58

A. 3904

TD 3925'

ABANDONED

County Sumner Elev. 1127
 Sec. 1 Twp. 33 Rge. 1E
 Company O. H. Parker
 Farm Name Matzen No. 1

TOPS	DEPTH	LOG	DATUM	Loc. in Sec.
Anh.				SE SE SW
Tp. <u>stall</u>		<u>2454</u>		
H.				
Tr.				
Dg.				
Bl.				
L.				Geol.
K.C.	<u>2871</u>	<u>2892</u>		Contr.
B.K.C.				<u>Capitt</u>
Ce.				Pool
C.				<u>Wildcat</u>
M. <u>chat</u>	<u>3467</u>	<u>3467</u>		
M.				
K.				
Mz.				
Ma.				
V.				
S.		<u>3836</u>		<div style="border: 1px solid black; padding: 5px; text-align: center;"> ABANDONED </div>
S. <u>sd</u>		<u>3842-58</u>		
A.		<u>3904</u>		
R.				
Pe.				
G.				
T.D.	<u>3925</u>			

Date Comm. MAY 9 1956
1100 APR 25 '56 9-20-56 85/8 120
1100 2266 MAY 2 '56 3682 MAY 9 '56

D & A

Co.
Lse.
No.
Sec.
T.
R.