


Section 17 Township 32 Range 5-E

Well No. #2 Lena

Company Phillips

Frog Hollow pool
NORTH

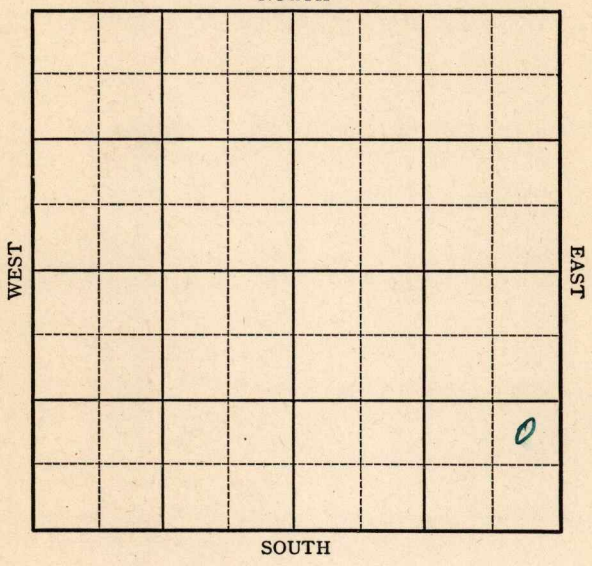

Sec. 17 Twp. 32 R. 5-E

Well No. #2 Lena Farm _____

Phillips Company

(Frog Hollow)


_____ Ft. from N. Line

998 Ft. from S. Line

330 Ft. from E. Line

_____ Ft. from W. Line

Elev. 1307

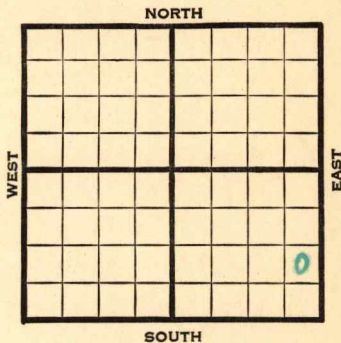

1941	REPORT
10/8	8" - 132' WOC.
10/16	Drlg. 2370'
10/23	Bart. 3020' 5" - 3025'
	T.D. 3040' RUST.
10/30	" " "
11/6	T.D. 3064' 1400' oil.
	Shot 80 qts. 3040-64' C.O.
11/12	Bart. 3020'
	5" - 3025'
	T.D. 3064'
	Shot 80 qts. 3040-64'
	Flow 1086 bbls., potential.
	39. Gravity
	COMPLETED

Map No. K-2 Sec. 17 Twp. 32 R. 5E

Well No. 2 Lena

Phillips Company

FIRST REPORT Contractor

NE SE SE

_____ Ft. from N. Line

998 Ft. from S. Line

330 Ft. from E. Line

_____ Ft. from W. Line

SECTION PLAT

			o

FROG HOLLOW POOL

Location _____

Rig up _____

Drilling and Remarks:

8" - 132'

Waiting on
cement to set

RECORD

Cased _____ in., _____ ft.

Sand _____

Gas _____

Oil _____

Total Depth _____

PRODUCTION

1st 24 hrs. Nat. _____

1st 24 hrs. after shot _____

Gas _____ Cu. Ft.

Dry Hole _____

Abandoned _____

Date

10-8-1941

S. J. LEWIS Scout

Map No. 7-2 Sec. 17 Twp. 32 R. 5E

Well No. 2 Lena

Phillips Company

COMPLETED Contractor

SECTION PLAT

			o

NE SE SE

_____ Ft. from N. Line

998 Ft. from S. Line

330 Ft. from E. Line

_____ Ft. from W. Line

FROG HOLLOW POOL

RECORD

Location _____

Cased _____ in., _____ ft.

Rig up _____

Sand _____

Drilling and Remarks:

Gas _____

Oil _____

Total Depth 3064

Bar 83020
5" @ 3025.
80 gals 3040-64
Flow 1086 Pt.
39 @ 42

PRODUCTION

1st 24 hrs. Nat. _____

1st 24 hrs. after shot _____

Gas _____ Cu. Ft.

Dry Hole _____

Abandoned _____

Date

NOV 1 1941

19

S. J. LEWIS

Scout