


Section 17 Township 32 Range 5-E

Well No. ~~#~~ Brothers ~~#~~ 1

Company Leader Oil Carter

Frog Hollow Pool

NORTH

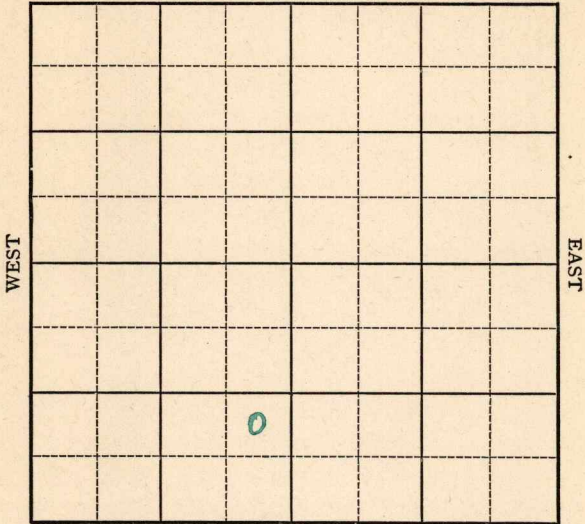

SOUTH

Sec. 17 Twp. 32 R. 5-E

Well No. #2 Brothers #1 Farm

Leader Oil Carter Oil Company


(Frog Hollow)

\_\_\_\_\_ Ft. from N. Line

990 Ft. from S. Line

330 Ft. from E. Line

\_\_\_\_\_ Ft. from W. Line

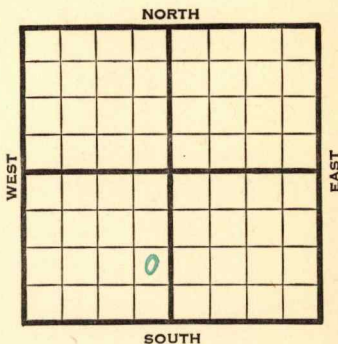

**Elev. 1258**

1942		REPORT			
6/10	Location				
6/17	"				
6/24	"				
7/1	"				
7/8	Spud.				
7/15	Shut down.				
7/22	" "				
7/29	<b>K.C. 2541</b>	<b>Bart. 3005'</b>			
8/5	5" - 2999 WOC				
8/12	SD				
8/19	TD 3027	swab 57 oil in 3 hrs.			
8/27	" "	" "	" "	" "	
9/2	" "	" "	" "	" "	
9/9	<b>Bart. 3005</b>	5" - 2999			
	T.D. 3027				
	Pump 158 Pot.				
	Gravity 40.6				

**COMPLETED**

Cowley

KANSAS

Map No. 2 Sec. 17 Twp. 32 R. 5E

Well No. 2 Brothers

Leader Oil Company

**FIRST REPORT**

Contractor

NE SE SW

SECTION PLAT

\_\_\_\_\_ Ft. from N. Line

990 Ft. from S. Line

330 Ft. from E. Line

\_\_\_\_\_ Ft. from W. Line


**FROG HOLLOW POOL**

Location XXX

Rig up \_\_\_\_\_

Drilling and Remarks:

RECORD

Cased \_\_\_\_\_ in., \_\_\_\_\_ ft.

Sand \_\_\_\_\_

Gas \_\_\_\_\_

Oil \_\_\_\_\_

Total Depth \_\_\_\_\_

PRODUCTION

1st 24 hrs. Nat. \_\_\_\_\_

1st 24 hrs. after shot \_\_\_\_\_

Gas \_\_\_\_\_ Cu. Ft.

Dry Hole \_\_\_\_\_

Abandoned \_\_\_\_\_

Date

**JUN 10 1942** 19

**S. J. LEWIS**

Scout



Map No. 2 Sec. 17 Twp. 32 R. 5E

Well No. 1 Brothers

Carter Oil Company

CORRECTION Contractor

NE SE SW

\_\_\_\_\_ Ft. from N. Line

990 Ft. from S. Line

330 Ft. from E. Line

\_\_\_\_\_ Ft. from W. Line

SECTION PLAT


FROG HOLLOW POOL

Location \_\_\_\_\_

Rig up \_\_\_\_\_

Drilling and Remarks:

Was Leader Oil

RECORD

Cased \_\_\_\_\_ in., \_\_\_\_\_ ft.

Sand \_\_\_\_\_

Gas \_\_\_\_\_

Oil \_\_\_\_\_

Total Depth \_\_\_\_\_

PRODUCTION

1st 24 hrs. Nat. \_\_\_\_\_

1st 24 hrs. after shot \_\_\_\_\_

Gas \_\_\_\_\_ Cu. Ft.

Dry Hole \_\_\_\_\_

Abandoned \_\_\_\_\_

Date

SEP 2 1942 19

S. J. LEWIS Scout

