
FORM 51 10M 12-46 PETROL KANSAS Butler county

Section 18 Township 25 Range 5-E

Well No. #20, Robinson

Company Ed Adair

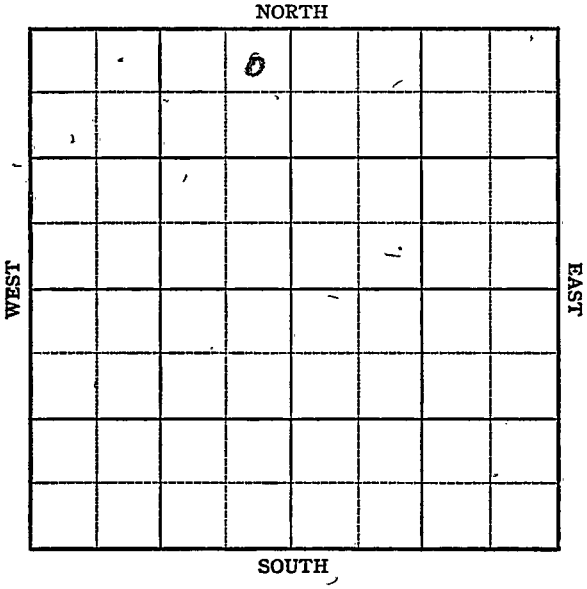

FORM 252-A
5M 12-45 PETROL

KANSAS

Butler County

Sec. 18 Twp. 25 R. 5E

Well No. 20 Robinson Farm

Ed Adair Company

Miscellaneous


330 Ft. from N. Line

Ft. from S. Line

330 Ft. from E. Line

Ft. from W. Line

NE NW

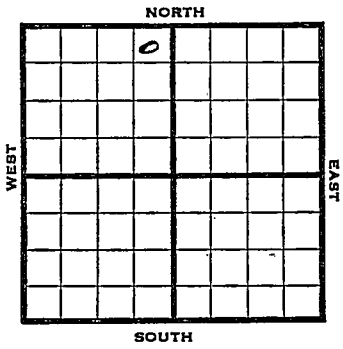

1947	Elev. 1411 REPORT
1/2	15" @ 215' Drlg 455'
1/8	Drlg 825'
1/15	Drlg 1730'
1/21	10" @ 1700 8" @ 2200 Drlg 2400'
1/29	TD 2705' Cong 2627

ABANDONED

Form 26 200 Bks. 10-46 Petrol

Kansas KANSAS Miscellaneous

Map No. 14 Sec. 18 Twp. 25 R. 5E

Well No. 20 Robinson

Ed Adair Company

FIRST REPORT Contractor

NE NW

330 Ft. from N. Line


Ft. from S. Line

330 Ft. from E. Line

Ft. from W. Line

Butler County

SECTION PLAT

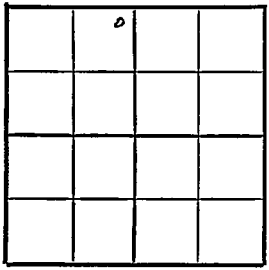

Location

Rig up

Drilling and Remarks:

15" @ 215

drlg. 455

RECORD

Cased in., ft.

Sand

Gas

Oil

Total Depth

PRODUCTION

1st 24 hrs. Nat.

1st 24 hrs. after shot

Gas Cu. Ft.

Dry Hole

Abandoned

Date

JAN 2 1947

19

S. J. LEWIS Scout

Form 26 200 Bks. 10-46 Petrol

Miscellaneous.

Kansas

Map No. 14 Sec. 18 Twp. 25 R. 5E

Well No. 20 Robinson

Ed Adair Company


ABANDONED

Contractor

NE NW

E11411

SECTION PLAT

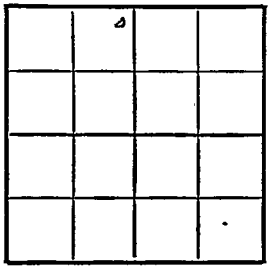

330 Ft. from N. Line

Ft. from S. Line

330 Ft. from E. Line

Ft. from W. Line

Butler County

Location

Rig up

Drilling and Remarks:

Comp 2627

RECORD

Cased in., ft.

Sand

Gas

Oil

Total Depth 2745

PRODUCTION

1st 24 hrs. Nat.

1st 24 hrs. after shot

Gas Cu. Ft.

Dry Hole

Abandoned

Date

JAN 29 1947 19

S. J. LEWIS Scout