

Butler

Section 18 Township 25 Range 5E

Well No. 21 Robinson

Company E. Adair


Sec. 18 Twp. 25 R. 5E 1

Well No. 21 Robinson Farm

E. Adair Company
Butler County


990 Ft. from N. Line

 Ft. from S. Line

 Ft. from E. Line

990 Ft. from W. Line

SE NW SE

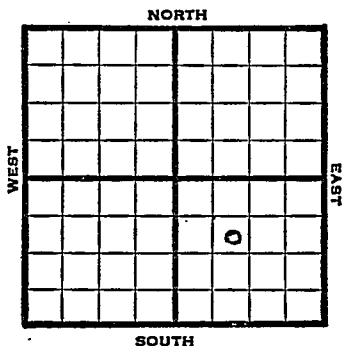

1947 Elev. 1390' REPORT

3/26 Machine.

4/2 Drlg. 185

4/9 15" @ 180'
12" @ 898'
Drlg. 975'.

4/15 10" @ 1685'
Drlg. 1875'

4/23 Lans 1825'
KC 2095'
8" @ 2220'
Drlg 2420'

4/29 Miss 2550'
6" @ 2560
TD 2577'
800' oil 2 hrs

5/7 TD 2577'
800' oil 2 hrs.

5/14 Miss 2550'
6" @ 2560'
Pump 50 Pot
39.0 Gr.
TD 2577'

COMPLETED

Kansas

Map No. K 14 Sec. 18 Twp. 25 R. 5EWell No. 21 RobinsonE. Adair

Company

FIRST REPORT

Contractor

SE NW SE

SECTION PLAT

990 Ft. from N. Line Ft. from S. Line Ft. from E. Line990 Ft. from W. LineButler CountyLocation Rig up

Drilling and Remarks:

Machine

RECORD

Cased in., ft.Sand Gas Oil Total Depth

PRODUCTION

1st 24 hrs. Nat. 1st 24 hrs. after shot Gas Cu. Ft.Dry Hole Abandoned

Date

MAR 26 1947 19S. J. LEWIS

Scout

Kansas Miscellaneous

Map No. K14 Sec. 18 Twp. 25 R. 5EWell No. 21 RobinsonE. Adair

Company

COMPLETE

Contractor

SE NW SE

E 1/1390**SECTION PLAT**

990 Ft. from N. Line Ft. from S. Line Ft. from E. Line990 Ft. from W. LineButler CountyLocation Rig up

Drilling and Remarks:

Miss 25506 102560Page 5039 3/4**RECORD**Cased in., ft.Sand Gas Oil Total Depth 2577**PRODUCTION**1st 24 hrs. Nat. 1st 24 hrs. after shot Gas Cu. Ft.Dry Hole Abandoned

Date

MAY 14 194719S. J. LEWIS Scout