
FORM 51

Butler KANSAS

Section 18 Township 25 Range 5 E

Well No. # 23 Robison

Company ~~Franco-Central~~

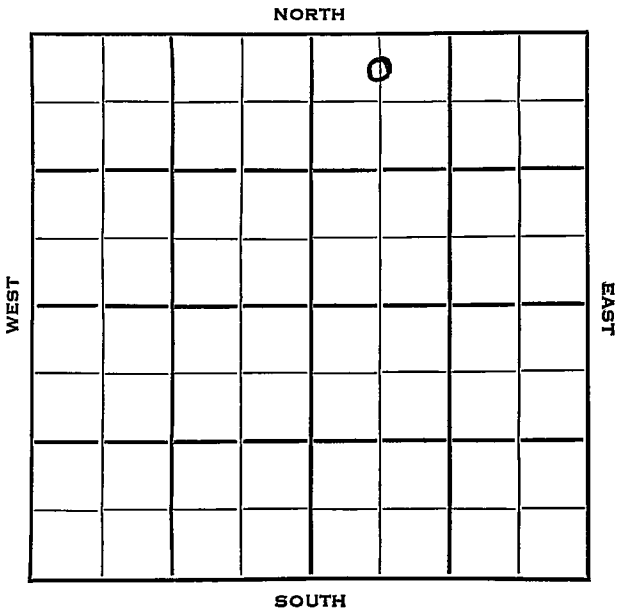

FORM 252-B

Butler

KANSAS

Sec. 18 Twp. 25 R. 5E

Well No. #23 Robison Farm

Franco-Central Company

Wixon Contractor

ElDorado Pool


330 Ft. from N. Line

_____ Ft. from S. Line

_____ Ft. from E. Line

660 Ft. from W. Line

C N L NW NE

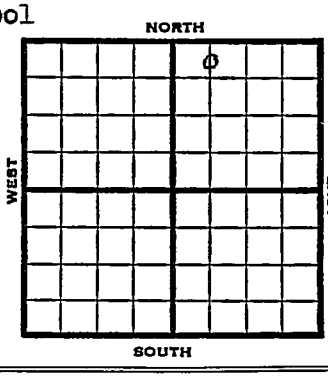

1953	Elev. 1422' REPORT
8/26	Spud 8-25-53
9/30	D & A Spud 8-25-53 TD 2660' 13" @ 921' 10" @ 1630' 8" @ 1997' Lans 1835, KC 2138 5" @ 2624' Miss 2570 TD 2660' D & A

ABANDONED

FORM 275 FOR SALE BY KANSAS BLUE PRINT CO.


County Butler State Kansas

Sec. 18 (Blk. Twp.) 25 (Sur. Rge.) 5E Map No.

Operator Franco-Central

Well No. 23 Farm Robison

Elev. Location C N L NW NE

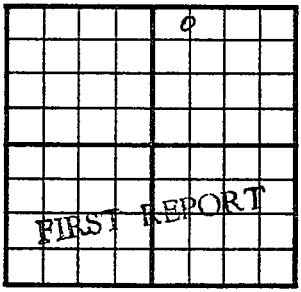

330 Ft. From N Line NE

660 Ft. From W Line Quarter

1st. Report AUG 26 1953

Completion

Remarks

Wixon - Contr.

Spudding Date 8-25-53

Drlg. Data

ElDorado Pool

J. G. McGEHEE.

FORM 275 FOR SALE BY KANSAS BLUE PRINT CO.


County Butler State Kansas

Sec. 18 (Blk. Twp.) 25 (Sur. Rge.) 5E Map No.

Operator Franco-Central

Well No. 23 Farm Robison

Elev. 1422 Location C N L NW NE

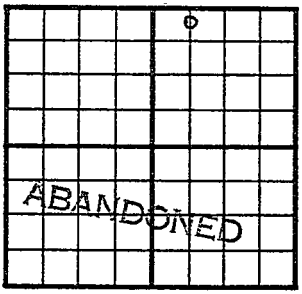

330 Ft. From N Line NE

660 Ft. From W Line Quarter

1st. Report

Completion SEP 30 1953

Remarks ElDorado Pool

Wixon - Contr.

Spudding Date 8-25-53

Drlg. Data D & A TD 2660

13" @ 921 10" @ 1630 8" @ 1997

Lans. 1835 KC 2138 5" @ 2624

Miss. 2570 TD 2660

D & A

J. G. McGEHEE