




KANSAS

Map No. \_\_\_\_\_ Sec. 18 Twp. 25 R. 5

Well No. 1 - Robinson Farm  
Effaw et al Company

NORTH

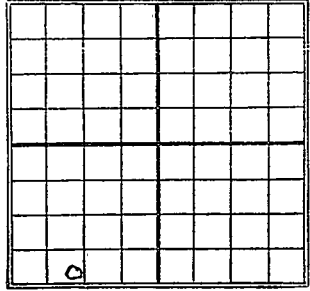

\_\_\_\_\_ Ft. from N. Line

200 Ft. from S. Line

\_\_\_\_\_ Ft. from E. Line

1120 Ft. from W. Line

SOUTH

1928

Date

REPORT

5/24 657-665 show  
12. x a. 800'

Butler

14 KANSAS  
 Map No. \_\_\_\_\_ Sec. 18 Twp. 75 R. 5

Well No. 1 Robinson  
 Egan et al Company

FIRST REPORTS

Contractor

COMPLETED

SECTION PLAT

\_\_\_\_\_ Ft. from N. Line

700 Ft. from S. Line

\_\_\_\_\_ Ft. from E. Line

1120 Ft. from W. Line

o			o

Location \_\_\_\_\_

Rig up \_\_\_\_\_

Drilling and Remarks:

RECORD

Cased \_\_\_\_\_ in., \_\_\_\_\_ ft.  
 Sand 657-665 show  
 Gas \_\_\_\_\_  
 Oil \_\_\_\_\_  
 Total Depth 700

PRODUCTION

1st 24 hrs. Nat. \_\_\_\_\_  
 1st 24 hrs. after shot \_\_\_\_\_  
 Gas \_\_\_\_\_ Cu. Ft.  
 Dry Hole   
 Abandoned

Date

MAY 24 1928 CHAS. L. SHERWOOD  
 \_\_\_\_\_ 192 \_\_\_\_\_ Scout