

Map No. Sec. 19 Twp. 25 R. 5
 Well No. 3 - Hemming Farm
Hemming et al Company

NORTH

WEST

EAST

SOUTH

Location

Drilling Remarks

Rig Up

Drilling Remarks

RECORD

Cased in. ft.

Sand

Gas

Oil

Total Depth

PRODUCTION

1st 24 hrs. Nat.

1st 24 hrs. after shot

Gas cu. ft.

Dry Hole

Abandoned

Map No. **KANSAS** Sec. 19 Twp. 25 R. 5


Well No. 3-Deemering Farm
Deemering Oil Company

_____ Ft. from N. Line

1000 Ft. from S. Line

1000 Ft. from E. Line

_____ Ft. from W. Line

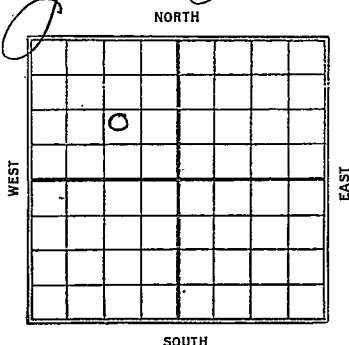

1928

Date

REPORT

5/24 712-726 T.D. 726
20/20 bbls

14 KANSAS

Butler

MAP No. _____ SEC. 19 TWP. 25 R. 5

WELL No. 3 Denning

Denning Oil Co

COMPANY

CONTRACTOR

FIRST REPORTS

SECTION PLAT

COMPLETED

Ft. FROM N. LINE

1000

Ft. FROM S. LINE

1000

Ft. FROM E. LINE

Ft. FROM W. LINE

	0		

RECORD

LOCATION _____

CASED _____ IN. _____ FT.

RIG UP _____

SAND 712-726

DRILLING AND REMARKS:

GAS _____

OIL _____

TOTAL DEPTH 726

PRODUCTION

1ST 24 HRS. NAT. _____

1ST 24 HRS. AFTER SHOT _____

GAS _____ CU. FT.

DRY HOLE _____

ABANDONED _____

DATE

MAY 24 1928

CHAS. L. SHERWOOD

192

SCOUT