

Map No. KANSAS Sec. 18 Twp. 25 R. 5


Well No. 2 Robison Farm
Effaw et al Company

_____ Ft. from N. Line

200 Ft. from S. Line

_____ Ft. from E. Line

760 Ft. from W. Line

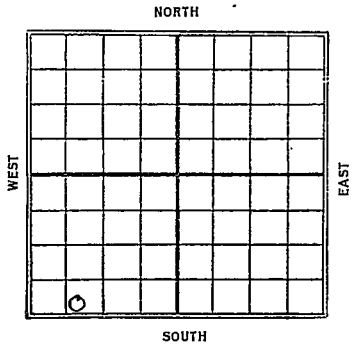

1928

Date

REPORT

524 650-55 show
T.D. 663' HFW - 11 + 9.

Butler

14 KANSAS Map No. Sec. 18 Twp. 25 R. 5

Well No. Robinson

Byzant et al Company

Contractor

FIRST REPORTS COMPLETED

SECTION PLAT

_____ Ft. from N. Line

700 Ft. from S. Line

_____ Ft. from E. Line

760 Ft. from W. Line

Location _____

Rig up _____

Drilling and Remarks:

RECORD

Cased _____ in.,
 Sand 650-55' show
 Gas _____
 Oil _____
 Total Depth 663 ft

PRODUCTION

1st 24 hrs. Nat. _____
 1st 24 hrs. after shot _____
 Gas _____ Cu. Ft.
 Dry Hole ✓
 Abandoned ✓

Date

MAY 24 1928

CHAS. L. SHERWOOD