

KANSAS


Cowley

FORM 51 5M 10-41 PETROL

Section 17 Township 32 Range 5-E

Well No. #1 Walker

Company Leader & Zephyr

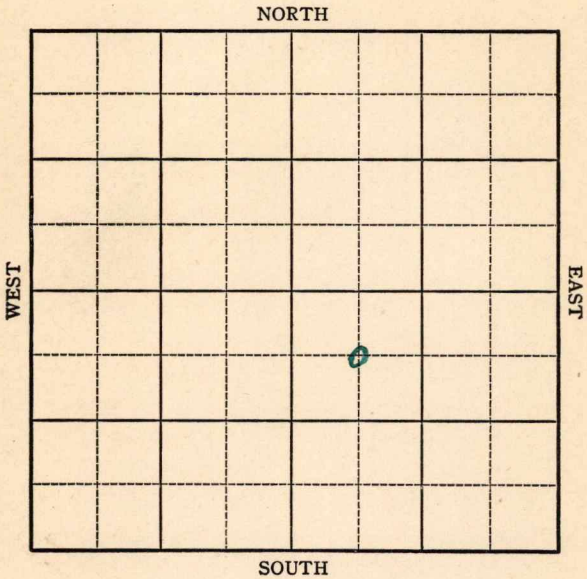

KANSAS

Cowley

Sec. 17 Twp. 32 R. 5-E

Well No. #1 Walker Farm

Leader & Zephyr Company

(Frog Hollow)


660 Ft. from N. Line

Ft. from S. Line

Ft. from E. Line

660 Ft. from W. Line

Elev. 1262

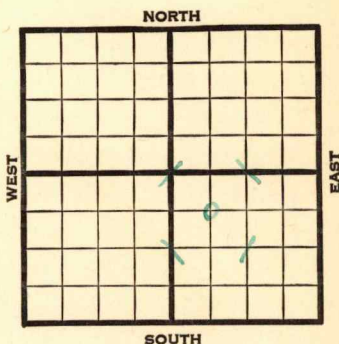

1942	REPORT
5/6	Location
5/13	"
5/20	Spud 45'
5/27	8" - 92' Drlg. 2355'
6/3	Bart. 3000' 7" - 3000'
	Drlg. 3016'
6/10	T.D. 3022' Shot 40 qts. 3005-21'
	Temp. potential 58 bbls.
6/17	" " "
6/24	Shot 120 qts. 3007-21' C.O.
7/1	Bart. 3000'
	7" - 3000'
	T.D. 3022'
	Shot 40 qts. 3005-21'
	Shot 120 qts. 3007-21'
	Pump 369 oil & 51 water.
	40.6 Gravity
	COMPLETED

Map No. 2 Sec. 17 Twp. 32 R. 5EWell No. 1 WalkerLeader & Zephyr

Company


FIRST REPORT

Contractor

C NW SE

660 Ft. from N. Line Ft. from S. Line Ft. from E. Line660 Ft. from W. Line

SECTION PLAT

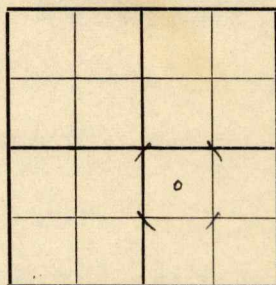

FROG HOLLOW POOL

Location XXRig up

Drilling and Remarks:

RECORD

Cased in., ft.Sand Gas Oil Total Depth

PRODUCTION

1st 24 hrs. Nat. 1st 24 hrs. after shot Gas Cu. Ft.Dry Hole Abandoned

Date

MAY 6 1942 19

S. J. LEWIS

Scout

KANSAS

Cowley

Map No. 2 Sec. 17 Twp. 32 R. 5EWell No. 1 Walker

Leader & Zephyr

Company

COMPLETED

Contractor

C NW SE

SECTION PLAT

660 Ft. from N. Line

Ft. from S. Line

Ft. from E. Line

660 Ft. from W. Line

		6	

FROG HOLLOW POOL

Location

Rig up

Drilling and Remarks:

*Bar 3000**7" @ 3000**409 @ 3005-21**120 " 3007-21**Pump .369 oil + 57 lbs**406 gr*

RECORD

Cased _____ in., _____ ft.

Sand _____

Gas _____

Oil _____

Total Depth 3022

PRODUCTION

1st 24 hrs. Nat. _____

1st 24 hrs. after shot _____

Gas _____ Cu. Ft.

Dry Hole _____

Abandoned _____

Date

JUL 1 1942 19S. J. LEWIS

Scout