


Map No. _____ Sec. 19 Twp. 25 R. 5

Well No. 4 - Demming Farm _____
Demming Oil Company

NORTH (Demming)

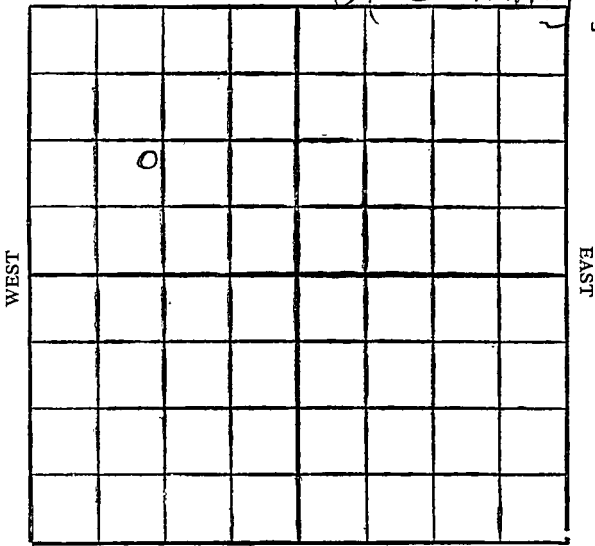

Location

Drilling Remarks

.....

.....

RECORD

Cased..... in. ft.

Sand

Gas

Oil

Total Depth.....

Rig Up.....

Drilling Remarks

.....

.....

PRODUCTION

1st 24 hrs. Nat.....

1st 24 hrs. after shot.....

Gas..... cu. ft.

Dry Hole.....

Abandoned.....

Butler

14 KANSAS

MAP No. _____ SEC. 19 TWP. 75 R. 5

WELL No. 4 DENMINN

Denminn Oil Co

COMPANY

FIRST REPORTS.

CONTRACTOR

COMPLETED

SECTION PLAT

_____ FT. FROM N. LINE

1000

_____ FT. FROM S. LINE

1400

_____ FT. FROM E. LINE

_____ FT. FROM W. LINE

⊙			

LOCATION _____

RIG UP _____

DRILLING AND REMARKS:

15/20 Bls.

RECORD

CASED _____ IN. _____ FT.

SAND 733-752

GAS _____

OIL _____

TOTAL DEPTH 752

PRODUCTION

1ST 24 HRS. NAT. _____

1ST 24 HRS. AFTER SHOT _____

GAS _____ CU. FT.

DRY HOLE _____

ABANDONED _____

DATE

MAY 2 1928

CHAS. L. SHERWOOD

192

SCOUT