


Section 18 Township 16 Range 11-W

Well No. #6 Schartz

Company Solar Oil

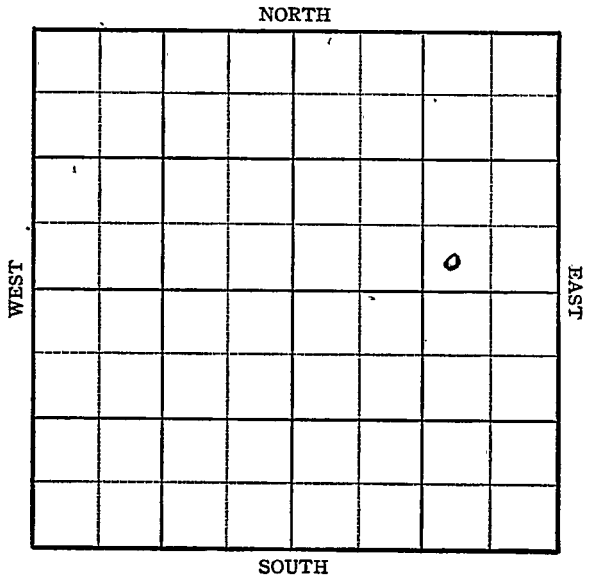

KANSAS

Barton County

Sec. 18 Twp. 16 R. 11W

Well No. #6 Schartz Farm

Solar Oil


Kraft-Prusa Company

 Ft. from N. Line

330 Ft. from S. Line

990 Ft. from E. Line

 Ft. from W. Line

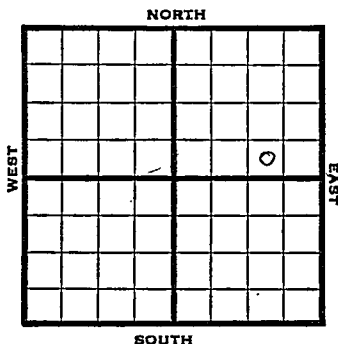

SW SE NE

1946 Elev. ^{1894²} 3294 REPORT

3/6 Location
3/14 Anhy 700' 8" - 713'
WOC.

3/21 Topeka 2685'
Drlg. 2910'

3/28 Lans. 3018' Arb. 3293'
T.D. 3294' 5" - 3293'
RUST.

4/3 Arb. 3293
5" @ 3293
500 acid.
TD 3294'
Depth Pot. 1250
Grav. 42.0

COMPLETED

~~KANSAS~~ Kansas Pool Name Kraft-Prusa
 Map No. 52 Sec. 18 Twp. 16 R. 11W

Well No. 6 Schartz

Solar Oil Company

FIRST REPORT Contractor

SW SE NE

SECTION PLAT

			D

 Ft. from N. Line

330 Ft. from S. Line

990 Ft. from E. Line

 Ft. from W. Line

Barton County

Location X

Rig up

Drilling and Remarks:

RECORD

Cased in., ft.

Sand

Gas

Oil

Total Depth

PRODUCTION

1st 24 hrs. Nat.

1st 24 hrs. after shot

Gas Cu. Ft.

Dry Hole

Abandoned

Date

MAR 6 1946 19

S. J. LEWIS Scout

KANSAS Kansas Pool Name Kraft-Prusa

Map No. 55 Sec. 18 Twp. 16 R. 11W

Well No. 6 Schartz

Solar Oil Company

COMPLETED

Contractor

SW SE NE

E11877
SECTION PLAT

_____ Ft. from N. Line

330 Ft. from S. Line

990 Ft. from E. Line

_____ Ft. from W. Line

Barton County

Location _____

Rig up _____

Drilling and Remarks:



RECORD

Cased _____ in., _____ ft.

Sand _____

Gas _____

Oil _____

Total Depth 8294

PRODUCTION

1st 24 hrs. Nat. _____

1st 24 hrs. after shot _____

Gas _____ Cu. Ft.

Dry Hole _____

Abandoned _____

Date

APR 3 1946

S. J. LEWIS Scout