


Section 18 Township 16 Range 11-W

Well No. #8 Schartz

Company Solar Oil Company

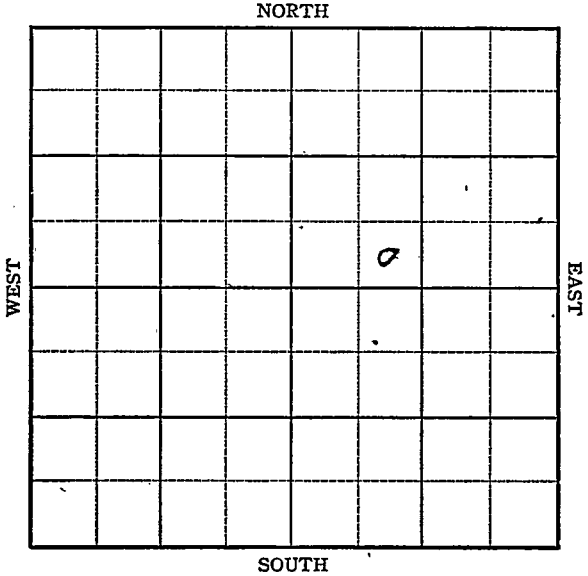

Sec. 18 Twp. 16 R. 11W

Well No. #8 Schartz Farm
 Solar Oil Company


Kraft-Pursa

_____ Ft. from N. Line

330 Ft. from S. Line

_____ Ft. from E. Line

990 Ft. from W. Line

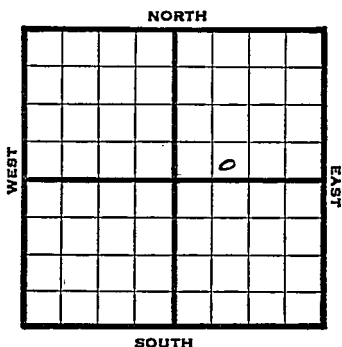

SE SW NE

1946 1873 REPORT

| | | | |
|-------|-------------------------|---|---|
| 9/25 | Location | | |
| 10/1 | Anhy 715' | | |
| | 8" @ 722 WOC | | |
| 10/8 | Drlg 3207' | | |
| 10/15 | Topeka 2665' | | |
| | Lans 3012 | | |
| | Granite wash 3356-58 TD | | |
| | 5" @ 3358' RUST | | |
| 10/22 | " " | " | " |
| 10/29 | " " | " | " |
| 11/6 | " " | " | " |
| 11/12 | " " | " | " |
| 11/20 | 48 shots 3281-90 | | |
| | Swb 6 oil PH | | |
| 11/27 | " " | " | " |
| 12/3 | " " | " | " |
| 12/11 | Lans 3012' | | |
| | Granite Wash 3356' | | |
| | 5" @ 3358' | | |
| | TD 3358' | | |
| | Perf Lans | | |
| | Pump 295 POT | | |
| | 42.4 Grav. | | |

COMPLETED

KANSAS

Kansas Pool Name Kraft-PursaMap No. 55 Sec. 18 Twp. 16 R. 11WWell No. 8 ScharztzSolar Oil

Company

FIRST REPORT

Contractor

SE SW NE

SECTION PLAT

| | | | |
|--|--|---|--|
| | | | |
| | | | |
| | | o | |
| | | | |
| | | | |

 Ft. from N. Line330 Ft. from S. Line Ft. from E. Line990 Ft. from W. LineBarton CountyLocation XRig up

Drilling and Remarks:

RECORD

Cased in., ft.Sand Gas Oil Total Depth

PRODUCTION

1st 24 hrs. Nat. 1st 24 hrs. after shot Gas Cu. Ft.Dry Hole Abandoned

Date

SEP 25 1946 19S. J. LEWIS

Scout

