


Section 18 Township 16 Range 11W

Well No. #13 Schartz

Company Solar Oil Company

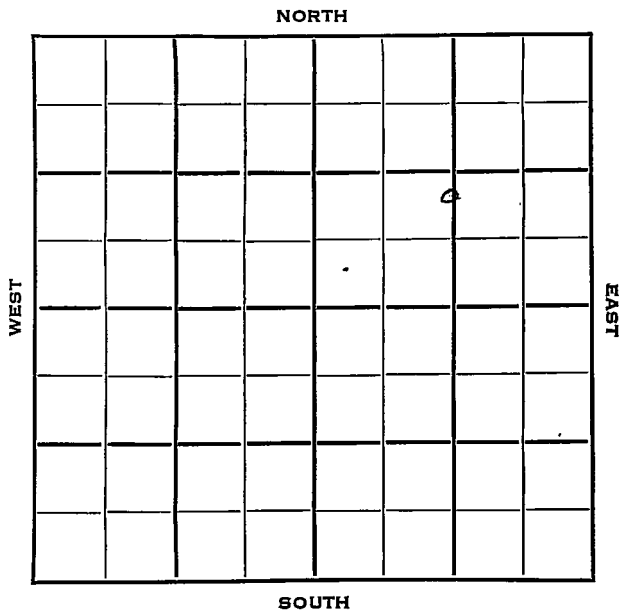

Barton KANSAS ✓

Sec. 18 Twp. 16 R. 11 W

Well No. # 13 Schartz Farm

Solar Oil Company

D & M Drlg. Contractor


\_\_\_\_\_ Ft. from N. Line

990 Ft. from S. Line

1320 Ft. from E. Line

\_\_\_\_\_ Ft. from W. Line

C N L S/2 NE

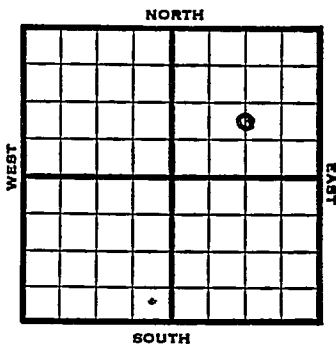

1953 Elev. 1867' REPORT

2/11 Spud 2-5-53  
8" @ 711 Anhy 702

Drlg. 1848'

2/19

Top 2655'

DST 2847-60, 40 mins, 10' M Off

Heeb 2898' Doug sd 2944'

DST 2922-56, 1 hr, 100' M & W

plus SSG 600# Br li 2993'

Lans. 3011

DST 3154-92, 1 hr, 510' gas, 90' O CM  
280#

Cong 3288'

DST 3283-97, 40 mins, 8' SOCM

226

Arb 3296

DST 3306-14, 1 hr., 20' OCM,  
920#

DST 3350-55, 1 hr., 158' sulp  
wtr 985#

RTD 3355

5" @ 3352, CO

3/12

CO

3/19

NR

OVER

#13 Schartz

1953  
3/25

Spud 2-5-53  
Oil Well  
TD 3355  
8" @ 711  
Anhy 702, Top 2655,  
DST 2847-60, .opn 40 mins.,  
rec. 10' mud, 0#  
Heeb 2898, Doug 2944  
DST 2922-56, opn 1 hr., rec.  
100' mud & wtr & SSG, 600#  
Br lime 2993, Lans 3011  
DST 3154-92, opn 1 hr., rec.  
510' gas, 90' ocm, 280#  
Cong 3288  
DST 3283-97, opn 40mins.,  
rec. 8' socm,  
Arb. 3296  
DST 3306-14, opn 1 hr., rec.  
20' ocm, 920#  
DST 3350-55, opn 1 hr., rec.  
158' sul wtr., 985#  
TD 3355  
5" @ 3352  
CO to 3320  
13/3307-09 wtr.  
PB 3200  
18/3182-85, 500A  
P/6 bop 4 bwpd 3 days 300A  
Comp. 6 bopd 6 bw

**COMPLETED**



