KANSAS


FORM 51 5M PETROL

Barton

Section 19 Township 16 Range 11-W

Well No. #3 Hoffman

Company Black-Marshall

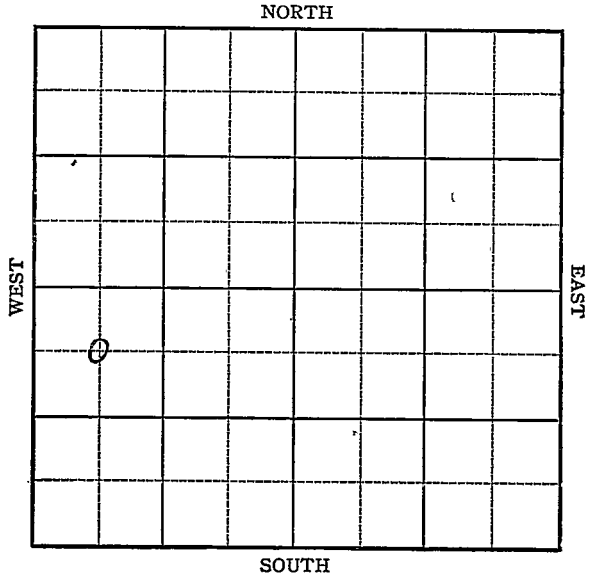

FORM 252-A
5M 9-43 GASS

KANSAS Barton

Sec. 19 Twp. 16 R. 11-W

Well No. #3 Hoffman Farm


Black-Marshall Company

660 Ft. from N. Line

Ft. from S. Line

Ft. from E. Line

660 Ft. from W. Line

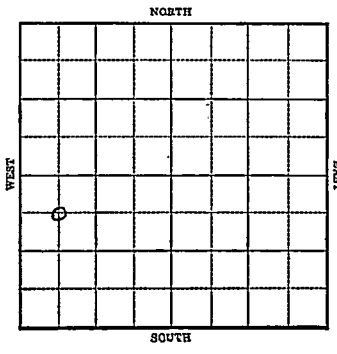

Elev. 1910

1943	REPORT
10/6	Location
10/13	"
10/20	"
10/27	Drlg. 360'
11/3	12" @ 405' Drlg. 750'
11/10	Anhy 770 10" @ 773' Drlg. 1560'
11/17	Drlg. 2080'
11/24	Drlg 2870 8" @ 2104
12/15	5" @ 3390 Basal 3385 T.D. 3391 Depth Pot 3317 Max 3000 Gravity 42.4

COMPLETED

Form 26 200 Bks 5-42 Petrol Barton

KANSAS

Map No. 65 Sec. 19 Twp. 16 R. 11W

Well No. 3 Hoffman

Black-Mershall Company

FIRST REPORT

Contractor

C NW SW


660 Ft. from N. Line

Ft. from S. Line

Ft. from E. Line

660 Ft. from W. Line

SECTION PLAT

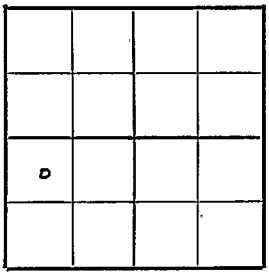

Kraft Prusa Pool

Location X

Rig up

Drilling and Remarks:

RECORD

Cased in., ft.

Sand

Gas

Oil

Total Depth

PRODUCTION

1st 24 hrs. Nat.

1st 24 hrs. after shot

Gas Cu. Ft.

Dry Hole

Abandoned

Date

OCT 6 1943 19

S. J. LEWIS Scout

Form 26 200 Bks 5-42 Petrol

Barton

KANSAS

Map No. 5 Sec. 19 Twp. 16 R. 11W

Well No. 3 Hoffman

Black-Marshall Company

COMPLETED Contractor

C NW SW


660 Ft. from N. Line

Ft. from S. Line

Ft. from E. Line

660 Ft. from W. Line

SECTION PLAT

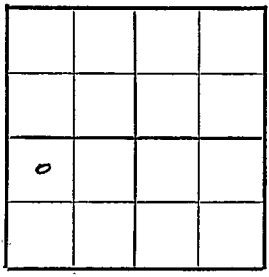

Kraft Prusa Pool

Location

Rig up

Drilling and Remarks:

Basal 3385
5" @ 3390
Dep Pd 3317
Max 8000

42 4 Gr

RECORD

Cased in., ft.

Sand

Gas

Oil

Total Depth 3391

PRODUCTION

1st 24 hrs. Nat.

1st 24 hrs. after shot

Gas Cu. Ft.

Dry Hole

Abandoned

Date

DEC 15 1943 19

S. J. LEWIS Scout