Barton


KANSAS

SECTION 19 TOWNSHIP 16S RANGE 11W

WELL NO. #6 Hoffman

COMPANY Saul Robinowitz (Tulsa)

NW SE
~~NE~~ ~~SW~~ SW

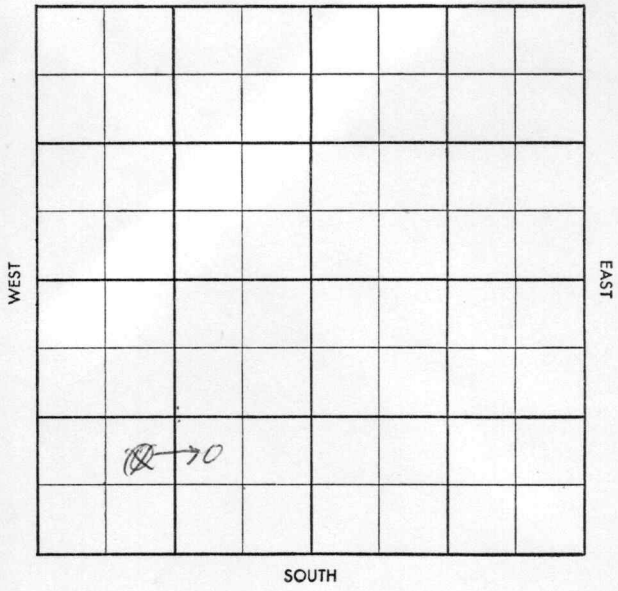

FORM 504-3 SUNRAY

Twp. X Pool X

Co. X Feesi D3

S-513-B

County Barton Elev.

Sec. 19 Twp. 16 Rge. 11W

Company Saul Robinowitz (Tulsa)

Farm Name Hoffman No. 6

TOPS	DEPTH	LOG	DATUM
Anh.			
Tp.			
H.			
Tr.			
Dg.			
B. L.			
L.			
K.C.			
B.K.C.			
Ce.			
C.			
M.			
M.			
K.			
Mz.			
Mq.			
V.			
S.			
S.			
A.			
R.			
Pf.			
G.			
T.D.			

Loc. in Sec. NE SW SW

Geol Teichman

Contr. Duke Drlg.

Pool Kraft-Prusa



Date Comm. 6-12-58

8" @ 313, Drlg. 2635

Co. Lse. No. Sec. T. R.

Twp. X Pool X

CORRECTION

Co. X Facat.

S-513-B

County Barton Elev 1909DF 1912KB

Sec. 19 Twp. 16 Rge. 11W

Company Saul Robinowitz (Tulsa)

Farm Name Hoffman No. 6

TOPS	DEPTH	LOG	DATUM
Anh.			
Tp.			
H.	2957		
Tr.			
Dg.			
B.L.	3053		
L.	3067		
K.C.			
B.K.C.			
Ce.			
C.	3337		
M.			
M.			
K.			
Mz.			
Mq.			
V.			
S.			
S.			
A.			
R.			
Pf.			
G.			
T.D.	3366		

Loc. in Sec. ~~NE SW SW~~ nw se sw

Geol. Teichman

Contr. Duke Drlg.

Pool Kraft-Prusa

ABANDONED
JUL 2 '58
O

Date Comm. 6-12-58

8" @ 313, Drlg. 2635 JUN 25 '58 DST 2985-3025 op/hr 45' M/ss o BHP 220/20

Ø3360 JUL 2 '58 DST 3320-66 1hr 330 gcmw 180 06 gcmw 120W

DHA