KANSAS

Barton


FORM 51 IOM 12-46 PETROL

Section 18 Township 16 Range 11W

Well No. 10 Schartz

Company Solar Oil

Kraft-Prusa

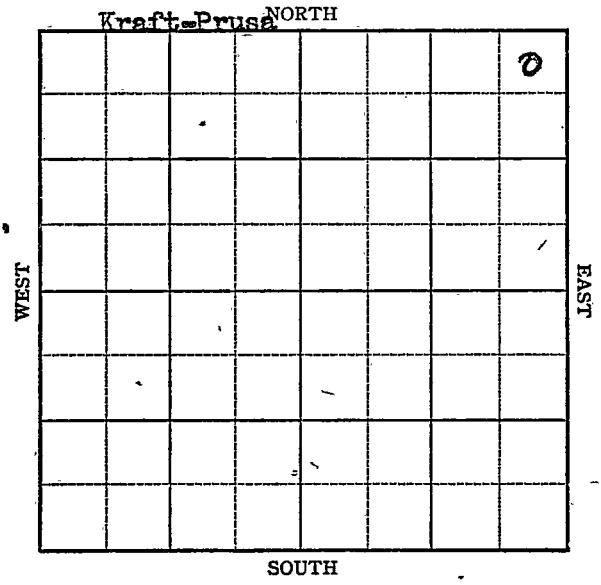

FORM 252-A
5M 12-46 PETROL

KANSAS Barton County

Sec. 18 Twp. 16 R. 11-W

Well No. 10 Schartz Farm

Solar Oil Company

Kraft-Prusa


330 Ft. from N. Line

Ft. from S. Line

330 Ft. from E. Line

Ft. from W. Line

NE/C

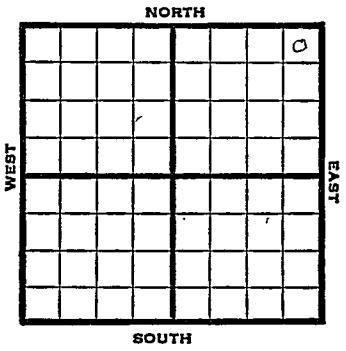

1947	Elev. 1865' REPORT
7/30	8" @ 717 Anhy 707 Topeka 2660 Lans. 3014 Drlg. 3125'
8/6	Arbuckle 3297' TD 3301' 5" @ 3298' RUST
8/13	Arbuckle 3308 corrected TD 3314'
8/20	TD 3321 HFW 48 shots 3186-90 2000 acid
8/27	42 shots 3106-16 750 acid Water
9/3	Arb. 3308' 5" @ 3298' TD 3321'

ABANDONED

Form 26 200 Bks. 10-46 Petrol

Kraft-Prusa

Kansas

Map No. ____ Sec. 18 Twp. 16 R. 11W

Well No. 10 Schartz

Solar Oil Company

FIRST REPORT Contractor

NE/C


330 Ft. from N. Line

Ft. from S. Line

330 Ft. from E. Line

Ft. from W. Line

SECTION PLAT

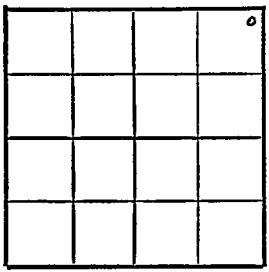

Barton County

Location

Rig up

Drilling and Remarks:

8" @ 717
anhy 707
Topeka 2660
Lans. 3014
drlg. 3125

RECORD

Cased ____ in., ____ ft.

Sand

Gas

Oil

Total Depth

PRODUCTION

1st 24 hrs. Nat.

1st 24 hrs. after shot

Gas ____ Cu. Ft.

Dry Hole

Abandoned

Date

JUL 30 1947 19

S. J. LEWIS Scout

Form 26 200 Bks. 10-46 Petrol

Kansas

Kraft Prusa Pool

Map No. 55 Sec. 18 Twp. 16 R. 11W

Well No. 10 Schartz


Solar Oil Company

ABANDONED Contractor

NE/C

E 1,865

SECTION PLAT

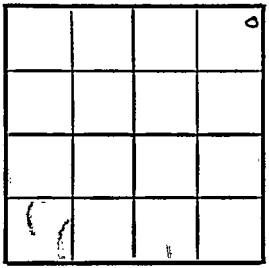

350 Ft. from N. Line

Ft. from S. Line

330 Ft. from E. Line

Ft. from W. Line

Barton County

Location

Rig up

Drilling and Remarks:

Ran 3308

5" @ 3298.

RECORD

Cased in., ft.

Sand

Gas

Oil

Total Depth 3321

PRODUCTION

1st 24 hrs. Nat.

1st 24 hrs. after shot

Gas Cu. Ft.

Dry Hole

Abandoned

Date

SEP 3 1947

S. J. LEWIS Scout