

Section 18 Township 16 Range 11W


Well No. #11 Schartz

Company Solar Oil

NORTH

WEST

EAST

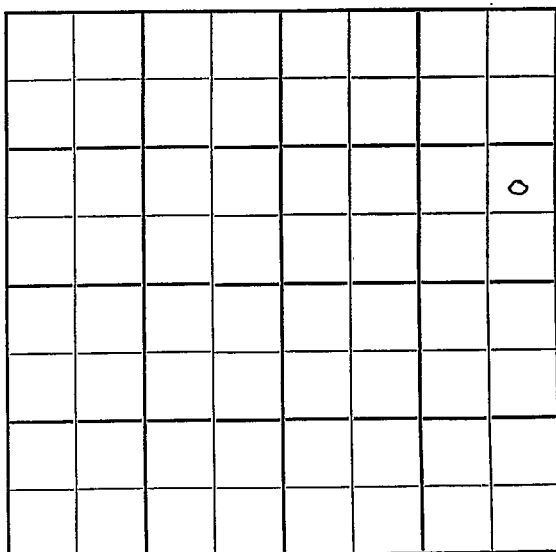

SOUTH

Sec. 18 Twp. 16 R. 11W

Well No. #11 Schartz Farm

Solar Oil Company

Contractor

**Kraft-Prusa Pool**

\_\_\_\_\_ Ft. from N. Line


NORTH

990 Ft. from S. Line

330 Ft. from E. Line

WEST

EAST

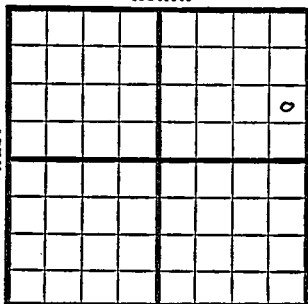

\_\_\_\_\_ Ft. from W. Line

SOUTH

NE SE NE

1951 Elev. 1877' REPORT

12/5 Spud 12-4-51  
Drlg. 100'

1952  
2/6 Spud 12-4-51  
Oil Well TD 3307  
8-5/8" @ 714'  
Anhy 704 Top. 2685  
Heeb. 2912 Br. Li 3004  
Lans. 3025  
DST 3111-21 open 1 hr. rec. 30'  
SOCM  
DST 3167-3203 open 1 hr. rec. 31'  
Arb. 3301  
DST 3301-07 open 3/4"hr. rec. 58'  
ocm TD 3307 5" @ 3303 CO to 3307  
900 A 1 boph Comp. 20 bopd

**COMPLETED**



County Barton State Kansas

Sec. 18 (Blk. 16 (Sur. 11W (Twp.) Rge.) Map No.

Operator Solar Oil

Well No. 11 Farm Schartz

Elev. 1877 Location NE SE NE

				0

990 Ft. From S Line NE

330 Ft. From E Line Quarter

1st. Report

Completion FEB 6 1952

Remarks Kraft-Prusa Pool

Braden Drlg. - Contr.

Spudding Date 12-4-51

Drlg. Data Oil well TD 3307

8 5/8" @ 714 Anhy 704 Top. 2685

Heeh. 2912 Br. lime 3004 Lans. 3025

DST 3111-21 open 1 hr. Rec. 30' socm

DST 3167-3203 open 1 hr. Rec. 31' socm

Arb. 3301 DST 3301-07 open 3/4 hr.

Rec. 58' ocm TD 3307 5" @ 3303

CO to 3307 900 A 41' 1" boph

Comp. 20 bopd