

K.A. Jones

FORM 51 5M 6-46 PETROL

Cowley county

Section 7 Township 35 Range 3-E

Well No. #6, Vickery "B"

Company Hill and Hill

NORTH

|   |  |  |  |  |  |  |  |
|---|--|--|--|--|--|--|--|
|   |  |  |  |  |  |  |  |
|   |  |  |  |  |  |  |  |
|   |  |  |  |  |  |  |  |
|   |  |  |  |  |  |  |  |
| 0 |  |  |  |  |  |  |  |
|   |  |  |  |  |  |  |  |
|   |  |  |  |  |  |  |  |
|   |  |  |  |  |  |  |  |

SOUTH

WEST EAST

12

KANSAS


Cowley County

Sec. 7 Twp. 35 R. 3EWell No. #6 Vickery "B" Farm  
Hill & Hill Company

## Miscellaneous

330 Ft. from N. Line         Ft. from S. Line         Ft. from E. Line330 Ft. from W. Line

NW SW

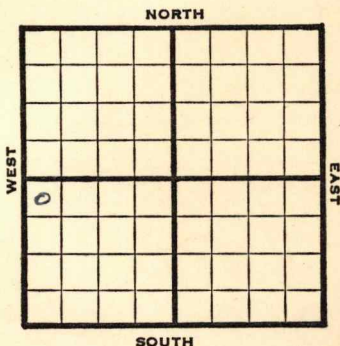

1946

**1185**

## REPORT

9/18 Surface Hole

9/24 10" @ 132'  
Drlg 1524'

10/1 Drlg 2589'

10/8 Drlg 3448'

10/15 **Bart 3450'**  
Drlg 3490'

10/22 TD3492'

10/29 "

11/6 12" @ 985', 1120 fsg

11/12 **Miss 3481'**  
TD 3492'

7" @ 3 464' PB 3483'

Swab 40 oil plus 20 W in 12 hrs

11/20 " " "

11/27 " " "

12/4 **Miss 3481'**

7" @ 3464'

TD 3492'

Pump 75 oil plus 20 W Pot

40 Grav.

**COMPLETED**

Kansas Pool Name Miscellaneous

KANSAS

Map No.        Sec. 7 Twp. 35 R. 3EWell No. 6 Vickery "B"Hill & Hill

Company

FIRST REPORT

Contractor

NW SW

## SECTION PLAT

330 Ft. from N. Line       Ft. from S. Line       Ft. from E. Line330 Ft. from W. Line

|   |  |  |  |
|---|--|--|--|
|   |  |  |  |
|   |  |  |  |
| 0 |  |  |  |
|   |  |  |  |

Cowley County

## RECORD

Location       Cased        in.,        ft.Rig up       Sand       

Drilling and Remarks:

Gas       Oil       Total Depth       

Surface Hole

## PRODUCTION

1st 24 hrs. Nat.       1st 24 hrs. after shot       Gas        Cu. Ft.Dry Hole       Abandoned       

Date

SEP 1 8 1946 19

S. J. LEWIS

Scout

KANSAS

Miscellaneous

Kansas

Map No.        Sec. 7 Twp. 35 R. 3EWell No. 6 Vickery "B"


Hill &amp; Hill

Company

COMPLETED

Contractor

NW SW

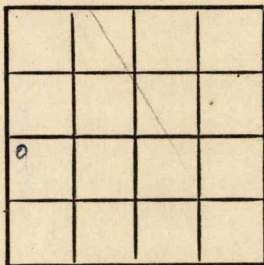E11183  
SECTION PLAT330 Ft. from N. Line       Ft. from S. Line       Ft. from E. Line330 Ft. from W. Line

Cowley County

## RECORD

Location       Cased        in.,        ft.Rig up       Sand       

Drilling and Remarks:

Gas       Oil       Total Depth 3492

## PRODUCTION

1st 24 hrs. Nat.       1st 24 hrs. after shot       Gas        Cu. Ft.Dry Hole       Abandoned       

Date

DEC 4 1946

19

S. J. LEWIS Scout