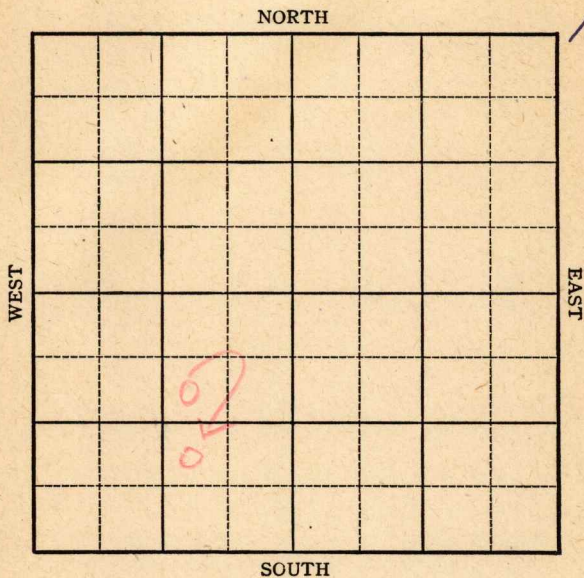


KANSAS

Cowley

Section 7 Township 35 Range 3EWell No. #3 Vickery "B"Company Hill & Hill

KANSAS

Cowley

Sec. 7 Twp. 35 R. 3E

Well No. #3 Vickers "B" Farm

Hill & Hill

Company

Miscellaneous

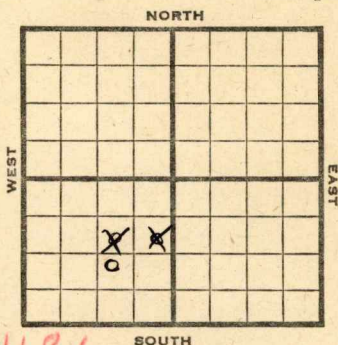
~~990~~ Ft. from N. Line

990 Ft. from S. Line

330
~~990~~ Ft. from E. Line

~~NW SE~~ Ft. from W. Line

~~SW NE SW~~ Edw. 1186



1945

R E P O R T

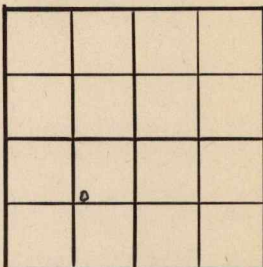
Date	Location
3/14	Location
3/23	"
3/29	"
4/5	"
4/12	"
4/20	"
4/27	"
5/3	"
5/16	Location abandoned

ABANDONED

Pool Name MiscellaneousMap No. 1 Sec. 7 Twp. 35 R. 3EWell No. 3 Vickery "B"Hill & Hill CompanyFIRST REPORT Contractor

SW NE SW

SECTION PLAT

990 Ft. from N. Line Ft. from S. Line990 Ft. from E. Line Ft. from W. Line

Cowley

Location XRig up

Drilling and Remarks:

RECORD

Cased in., ft.Sand Gas Oil Total Depth

PRODUCTION

1st 24 hrs. Nat. 1st 24 hrs. after shot Gas Cu. Ft.Dry Hole Abandoned

Date

MAR 14 1945 19

S. J. LEWIS Scout

Pool Name MiscellaneousMap No. 1 Sec. 7 Twp. 35 R. 3EWell No. 3 Vickery "B"Hill & Hill

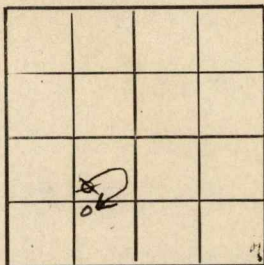
Company

CORRECTION

Contractor

NW SE SW

SECTION PLAT

 Ft. from N. Line990 Ft. from S. Line990 Ft. from E. Line Ft. from W. LineCowleyLocation Rig up

Drilling and Remarks:

reported
SW SE SW**RECORD**Cased in., ft.Sand Gas Oil Total Depth **PRODUCTION**1st 24 hrs. Nat. 1st 24 hrs. after shot Gas Cu. Ft.Dry Hole Abandoned

Date

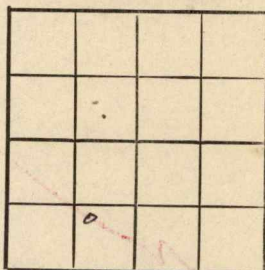
MAR 2 1 194519S. J. LEWISScout

Kansas Pool Name MiscellaneousMap No. 1 Sec. 7 Twp. 35 R. 3EWell No. 3 Vickory "B"
Hill & Hill Company

ABANDONED

Contractor

NW SE SW

E 1/184
SECTION PLAT

Ft. from N. Line

980 Ft. from S. Line990 Ft. from E. Line

Ft. from W. Line

Cowley CountyLocation ☒

Rig up

Drilling and Remarks:

RECORD

Cased _____ in., _____ ft.

Sand _____

Gas _____

Oil _____

Total Depth 600

PRODUCTION

1st 24 hrs. Nat. _____

1st 24 hrs. after shot _____

Gas _____ Cu. Ft.

Dry Hole _____

Abandoned Loc

Date

MAY 16 1945 19S. J. LEWIS Scout