
FORM 51 5M BRIX

KANSAS Barton County

Section 19 Township 16 Range 11W

Well No. #5 J. B. Hoffman

Company Black-Marshall

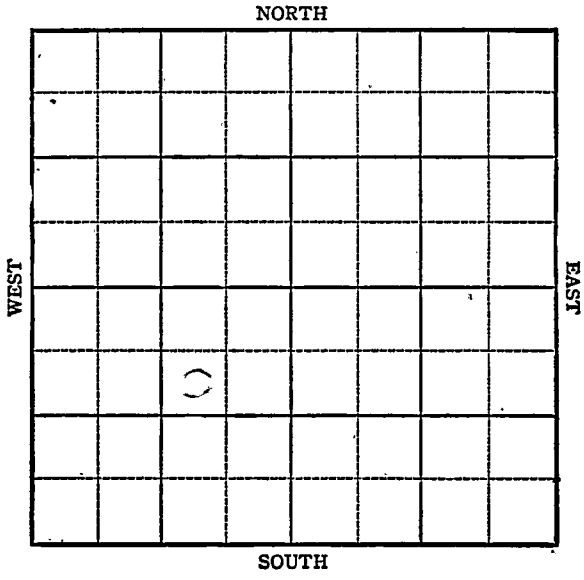

FORM 252-A
5M 9-44 PETROL

KANSAS Barton County

Sec. 19 Twp. 16 R. 11W

Well No. #5 J. B. Hoffman Farm

Black-Marshall Company


Kraft-Prusa

990 Ft. from N. Line

Ft. from S. Line

990 Ft. from E. Line

Ft. from W. Line

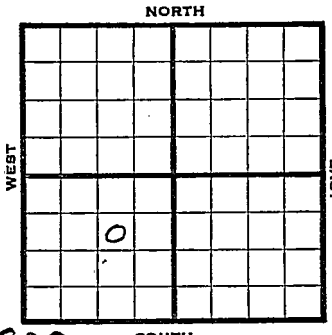

SW NE SW Elev. 1909

1944	REPORT
11/15	Location
11/24	"
11/29	8" @ 225 Drlg. 3178
12/6	Lans 3079 BKC 3328 Cong 3339 Quartzite 3363 TD 3366 5" @ 3364' Rust
12/14	" " "
12/21	" " "
12/27	Quartzite 3363 5" @ 3364 TD 3368 Pump 101 oil plus 12% water Grav. 41.0

COMPLETED

FORM 56 200 BKS, 1-44 PETROL

Pool Name Kraft-Prusa

Map No. J 5 Sec. 19 Twp. 16 R. 11W

Well No. 5 J. B. Hoffman

Black-Marshall Company

FIRST REPORT Contractor

SW NE SW


990 Ft. from N. Line

____ Ft. from S. Line

990 Ft. from E. Line

____ Ft. from W. Line

SECTION PLAT

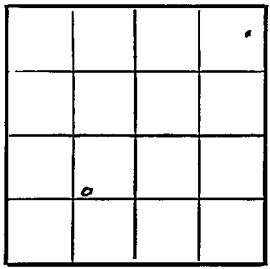

Barton

Location X

Rig up

Drilling and Remarks:

RECORD

Cased ____ in., ____ ft.

Sand

Gas

Oil

Total Depth

PRODUCTION

1st 24 hrs. Nat.

1st 24 hrs. after shot

Gas ____ Cu. Ft.

Dry Hole

Abandoned

Date

NOV 15 1944 19 S. J. LEWIS Scout

FORM 26 200 BKS 1-44 PETROL

Pool Name Kraft-Prusa

Map No. 5 5 Sec. 19 Twp. 16 R. 11W

Well No. 5 J. B. Hoffman

Black-Marshall Company

COMPLETED Contractor

SW NE SW


990 Ft. from N. Line

Ft. from S. Line

990 Ft. from E. Line

Ft. from W. Line

SECTION PLAT

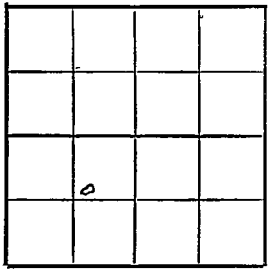

Barton County

Location

Rig up

Drilling and Remarks:

Quartzite 3363

5" @ 3364

Pump 10 bbl oil + 12% Water

41° Gr

RECORD

Cased in., ft.

Sand

Gas

Oil

Total Depth 3365'

PRODUCTION

1st 24 hrs. Nat.

1st 24 hrs. after shot

Gas Cu. Ft.

Dry Hole

Abandoned

Date

DEC 2 7 1944 19

S. I. LEWIS Scout