

Sumner

KANSAS

FORM 51 25M 3-49 PETROL

Section 9 Township 33 Range 2E

Well No. #1 Somer

Company Harbar et al

NORTH

6

			0				

WEST

EAST

SOUTH

Sec. 9 Twp. 33 R. _____

Well No. #1 Somer Farm _____
Harbar et al Company _____

Wildcat

_____ Ft. from N. Line

330'


_____ Ft. from S. Line

330'

_____ Ft. from E. Line

_____ Ft. from W. Line

SE SE NW

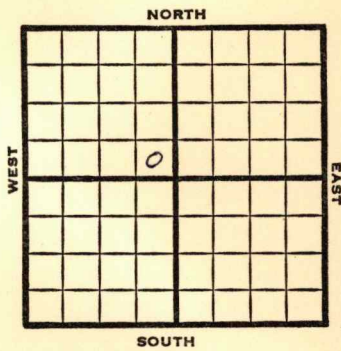

1950

Elev 1127'

REPORT

1/18

RUR

2/8

TD 3454'

Layton 2635'

KC 2700'

Simp 3330'

Arb. 3380'

D&A

Aband.

ABANDONED

Kansas

Wildcat

Map No. _____ Sec. 9 Twp. 33 R. 2E

Well No. 1 Somer

Harbar etal. Company

Contractor

SE SE NW

SECTION PLAT

_____ Ft. from N. Line

330 Ft. from S. Line

330 Ft. from E. Line

_____ Ft. from W. Line



Summer County

Location _____

Rig up _____

Drilling and Remarks:

R U R

RECORD

Cased _____ in., _____ ft.

Sand _____

Gas _____

Oil _____

Total Depth _____

PRODUCTION

1st 24 hrs. Nat. _____

1st 24 hrs. after shot _____

Gas _____ Cu. Ft.

Dry Hole _____

Abandoned _____

Date

JAN 18 1950 19

J. E. TYRA Scout

Map No. _____ Sec. 9 Twp. 33 R. 2E

Well No. 1 Somer

Harbar etal. Company

Contractor

SE SE NW

E. 1127
SECTION PLAT

_____ Ft. from N. Line

330 Ft. from S. Line

330 Ft. from E. Line
285

330 Ft. from W. Line

ABANDONED			

Sumner County

Location _____

Rig up _____

Drilling and Remarks:

Layton 2635
A.C. 2700
Simp 3330
arb 3380
D & A

RECORD

Cased _____ in., _____ ft.

Sand _____

Gas _____

Oil _____

Total Depth 3454

PRODUCTION

1st 24 hrs. Nat. _____

1st 24 hrs. after shot _____

Gas _____ Cu. Ft.

Dry Hole _____

Abandoned _____

Date

FEB 8 1950

19

J. E. TYRA

Scout