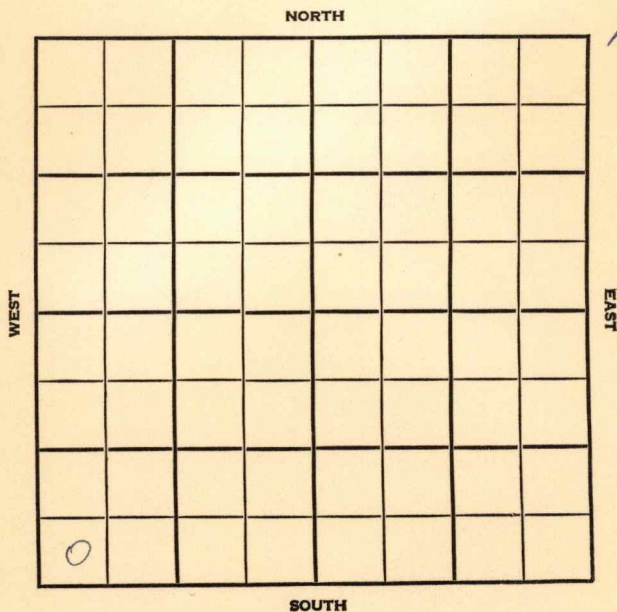


Section 14 Township 35 Range 3EWell No. #1 RippeCompany L. C. Smitherman

Cowley

KANSAS

SEC.

14

TWP.

35

R.

3E

WELL NO.

#1 Rippe

FARM

COMPANY

L.C. Smitherman

CONTRACTOR

WILDCAT


____ FT. FROM N. LINE

____ FT. FROM S. LINE

____ FT. FROM E. LINE

____ FT. FROM W. LINE

SW SW SW

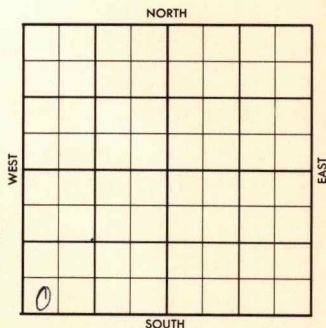

1956

ELEVATION

REPORT

8-29

Comm. 8-28-56
Spudding

County Cowley Elev. _____
 Sec. 14 Twp. 35 Rge. 3E
 Company L.C. Smitherman
 Farm Name Rippe No. 1

TOPS	DEPTH	LOG	DATUM	Loc. in Sec.
Anh.				SW SW SW
Tr.				DS-210/4
Dg.				
BL.				
L.				Geol.
K.C.				Contr.
B.K.C.				
Ce.				
C.				
M.				Pool
M.				WC
K.				
Mz.				
Ma.				
V.				
S.				
S.				
A.				
R.				
Pe.				
G.				
T.D.				

FIRST REPORT

AUG 29 '56

Date Comm. 8/28/56Spudding

SEP 2 1956

B. G.

Co.

County CoxleyElev. 1100Sec. 14 Twp. 35Rge. 3WCompany L.C. SmithmanFarm Name RippeNo. 1

TOPS	DEPTH	LOG	DATUM	Loc. in Sec.
Anh.				
Tp. <u>Stall</u>		<u>2254</u>		<u>SW 1/4</u>
H. <u>Lay</u>		<u>2700</u>		
Tr.				
Dg.				
Bl.				
L.				
K.C.		<u>2965</u>		Geol. _____
B.K.C. <u>OSW</u>		<u>3092</u>		Contr. _____
Ce. <u>Bartl</u>		<u>3412</u>		
C.				
M.				
M.				Pool _____
K.				<u>RIPPE</u>
Mz.				
Me.				
V.				
S.				
S.				
A.				
R.				
Pe.				
G.				
T.D.	<u>3449</u>			

Lse.

No.

Sec.

T.

R.

Date Comm. 8/23/56Spudding SEP 5 '56 (Crd Bartl) SEP 12 '56Pipe set. SEP 19 '56crd 3417-42 rec 25' sd. (sat.)DST 3412-42 on 1 in 50' VHOEGCM + 150' SW BHP 1270/35"4 1/2 @ 3449 co 32/3418-2910 60 + 3 Bwph nat. SEP 26 '56Frac \$ 100 BO + 100 BwphTER. OCT 3 '56 ✓ OCT 10 '56 POP OCT 17 '56P. 30 BOPd. + 150 Bwph. grav 38°

COMPLETE

00-24-56

0