


Section 9 Township 25 Range 5 EWell No. # 260 WilsonCompany Cities Service

NORTH

WEST

EAST

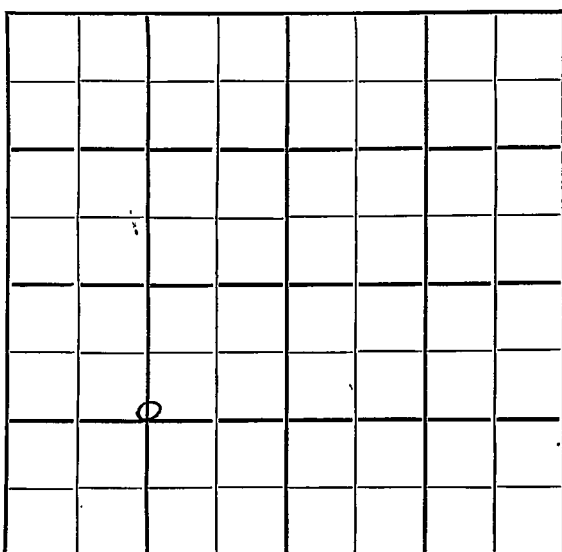

SOUTH

Butler

KANSAS

SEC. 9	TWP. 25	R. 5 E
-----------	------------	-----------

WELL NO.

260 Wilson

FARM

COMPANY

Cities Service


CONTRACTOR

1240 Ft. from N. Line

Ft. from S. Line

Ft. from E. Line

1390 Ft. from W. Line

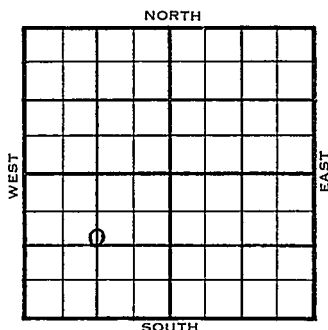C S $\frac{1}{2}$ N $\frac{1}{2}$ SW

1954

ELEVATION

1373'

REPORT

3/3 Oil well TD 2526'
10" @ 85' Lans. 1701 KC 1973
B KC 2137 Viola 2408
Simp 2449' Arb. 2521
TD 2522 5" @ 2521 DD 2526'
FU 1900' wtr. PB 2514 30/2497-2504
Comp. 60 BOPD

FIRST REPORT

COMPLETED

County **Butler** State **Kansas**
 Sec. **9** (Blk.) **25** (Sur.) **5E** Map No.

Operator **Cities Service**

Well No. **260** Farm **Wilson**

Elev. **1373** Location **C S $\frac{1}{2}$ W $\frac{1}{2}$ SW**

FIRST REPORT

COMPLETE

1240 Ft. From **N** Line **SW**

1390 Ft. From **W** Line **Quarter**

MAR 3 1954

1st. Report

Completion **MAR 3 1954**

Remarks

Spudding Date

Drlg. Data **Oil well TD 2526**

10" @ 85 Lens. 1701 KC 1973 B KC 213

Viola 2408 Simp. 2449 Arb. 2521

TD 2522 5" @ 2521 DD 2626 FU 1900' wtr

PB 2514 30/ 2497-2504 Comp. 60 bopd

J. G. McGEHEE