
FORM 51 5M BRIX

KANSAS Barton

Section 19 Township 16 Range 11W

Well No. #4 Redetzke

Company Black-Marshall

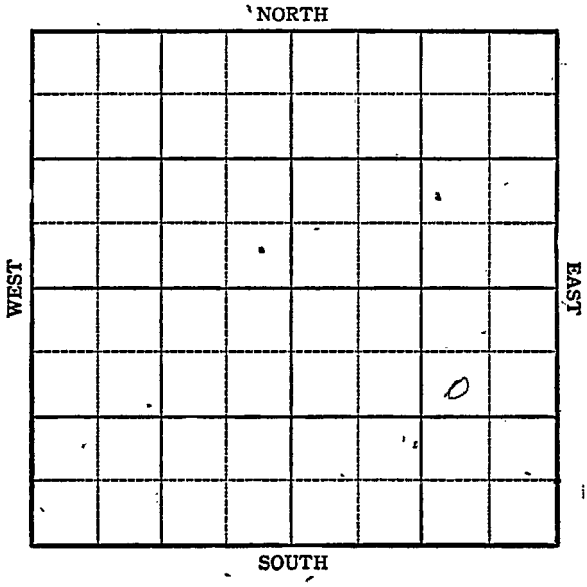

FORM 252-A
5M 3-44 PETROL

KANSAS Barton

Sec. 19 Twp. 16 R. 11W

Well No. #4 Redeszke Farm

Black-Marshall Company


Kraft-Prusa

990 Ft. from N. Line

Ft. from S. Line

990 Ft. from E. Line

Ft. from W. Line

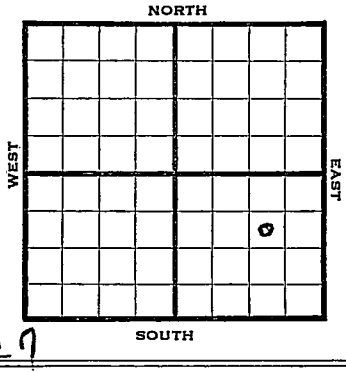

Elev. D.F. 1927

1944	REPORT
8/2	8" @ 246 1770' Drlg.
8/9	Anhy 780 Lans 3079 Drlg. 3340
8/16	Cong 3344 3392 in Cong TD 3392

ABANDONED.

FORM 26 200 BKS. 2-44 PETROL

KANSAS Pool Name Kraft-Prusa

Map No. 55 Sec. 19 Twp. 16 R. 11W

Well No. 4 Redetzke

Black-Marshall Company

FIRST REPORT Contractor

SW NE SE


990 Ft. from N. Line

_____ Ft. from S. Line

990 Ft. from E. Line

_____ Ft. from W. Line

SECTION PLAT

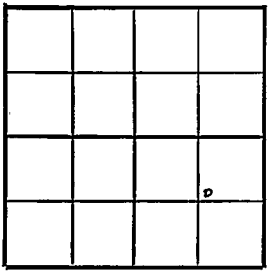

Barton County

Location

Rig up

Drilling and Remarks:

8" - 246

1770

RECORD

Cased ____ in., ____ ft.

Sand

Gas

Oil

Total Depth

PRODUCTION

1st 24 hrs. Nat.

1st 24 hrs. after shot

Gas ____ Cu. Ft.

Dry Hole

Abandoned

Date

AUG 2 1944 19 S. J. LEWIS Scout

FORM 26 200 BKS. 2-44 PETROL

KANSAS Pool Name Kraft Prusa Poo

Map No. 57 Sec. 19 Twp. 16 R. 11W

Well No. 4 Redetzke

Black-Marshall Company

ABANDONED Contractor

SW NE SE


990 Ft. from N. Line

Ft. from S. Line

990 Ft. from E. Line

Ft. from W. Line

SECTION PLAT

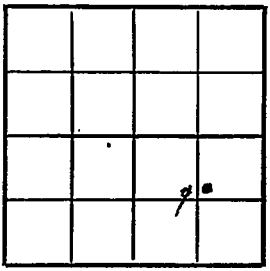

Barton

Location

Rig up

Drilling and Remarks:

Comp 3344

3392 in Comp

RECORD

Cased in., ft.

Sand

Gas

Oil

Total Depth 3392

PRODUCTION

1st 24 hrs. Nat.

1st 24 hrs. after shot

Gas Cu. Ft.

Dry Hole

Abandoned

Date

AUG 16 1944 19

S. J. LEWIS Scout