KANSAS


FORM 51 5M 1-42 PETROL

Barton

Section 19 Township 16 Range 11-W

Well No. #2 Redetzke

Company Black-Marshall

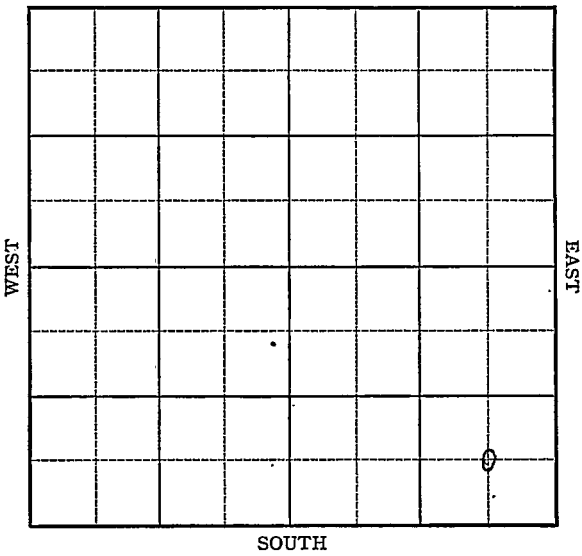


FORM 252-A
5M 9-43 GASS

KANSAS Barton

Sec. 19 Twp. 16 R. 11 W

Well No. #2 Redetzke Farm

Black-Marshall Company

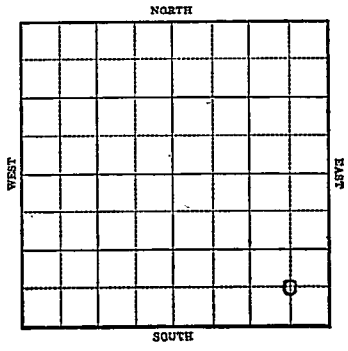

____ Ft. from N. Line

660 Ft. from S. Line

660 Ft. from E. Line

____ Ft. from W. Line

1943	Elev. 1900 REPORT
7/28	Cable rig
8/4	"
8/11	"
8/18	"
8/25	Drlg. 395'
9/1	12" @ 415'
	Anhy 751
	10" @ 751'
	Drlg. 1040'
9/8	Drlg. 1665'
9/15	Drlg. 2410' 8" @ 2375'
9/22	Topeka 2660
	8" @ 3424
	Drlg. 2930'
9/29	7 @ 3017'
	Lans 3047
	3205 UR 7"
10/6	Cong 3335.
	HPW
	T.D. 3376'

ABANDONED

Form 26 200 Bks 5-42 Petrol

KANSAS

Barton

Map No. 55 Sec. 19 Twp. 16 R. 11W


Well No. 2 Redetzke

Black-Marshall Company

FIRST REPORT Contractor

C SE SE

SECTION PLAT

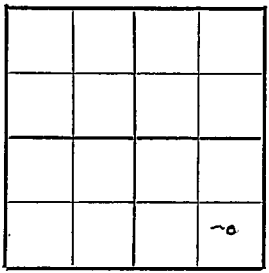

____ Ft. from N. Line

660 Ft. from S. Line

660 Ft. from E. Line

____ Ft. from W. Line

KRAFT PRUSA POOL

Location

Rig up

Drilling and Remarks:

Cable

RECORD

Cased ____ in., ____ ft.

Sand

Gas

Oil

Total Depth

PRODUCTION

1st 24 hrs. Nat.

1st 24 hrs. after shot

Gas ____ Cu. Ft.

Dry Hole

Abandoned

Date

JUL 2 8 1943 19

S. J. LEWIS Scout

Form 26 200 Bks 5-42 Petrol Barton

Map No. KANSAS Sec. 19 Twp. 16 R. 11W


Well No. 2 Redetzke

Black-Marshall Company

ABANDONED Contractor

C SE SE

SECTION PLAT

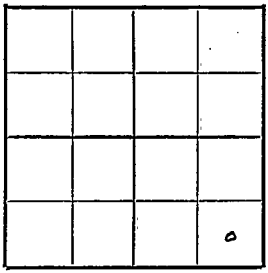

Ft. from N. Line

660 Ft. from S. Line

660 Ft. from E. Line

Ft. from W. Line

Kraft Prusa Pool

Location

Rig up

Drilling and Remarks:

Comp 3335

HPW.

RECORD

Cased in., ft.

Sand

Gas

Oil

Total Depth 3396

PRODUCTION

1st 24 hrs. Nat.

1st 24 hrs. after shot

Gas Cu. Ft.

Dry Hole

Abandoned

Date

OCT 6 1943 19

S. J. LEWIS Scout