


Map No. Kansas Sec. 19 Twp. 32 R. 5
 Well No. 4 Boyd Farm
Duffield et al Company

NORTH

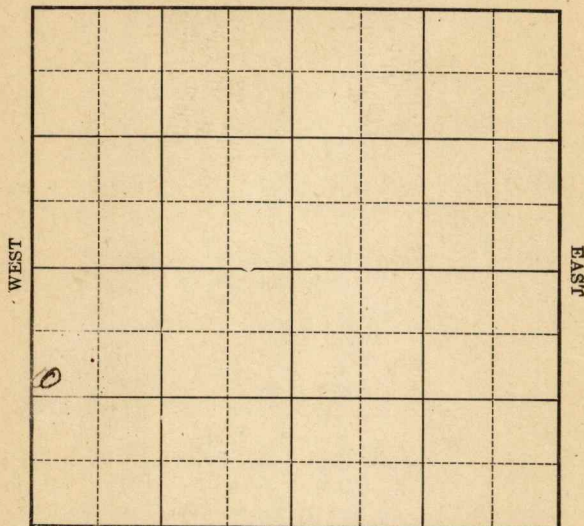

SOUTH

Location _____

Drilling Remarks

Rig Up _____

Drilling Remarks

RECORD

Cased _____ in. _____ ft.

Sand _____

Gas _____

Oil _____

Total Depth _____

PRODUCTION

1st 24 hrs. Nat. _____

1st 24 hrs. after shot _____

Gas _____ cu. ft.

Dry Hole _____

Abandoned _____

Cawley Co

Map No. _____ Sec. 19 Twp. 32 R. 5Well No. 4 Boyd Farm _____Duffield et al Company _____

NORTH

WEST

EAST

SOUTH

1070 Ft. from N. Line

_____ Ft. from S. Line

_____ Ft. from E. Line

256 Ft. from W. Line1926

Date

REPORT

3/3 Rig3/10 Spudding3/18 _____3/25 Alg 40004/1 " 13254/7 " 16504/14 " 19254/21 " 20004/28 " 22205/8 " 25055/12 " 27155/19 " 28206/1 Sand 3006-3031T.D. 3067 100 oil20 water

Cowby Co.
 K2 KANSAS Map No. _____ Sec. 19 Twp. 32 R. 5
 Well No. 4 Boyd
 Inghield et al Company
 Contractor

SECTION PLAT

1070 Ft. from N. Line
 _____ Ft. from S. Line
 _____ Ft. from E. Line
 250 Ft. from W. Line

o			

FIRST REPORTS

Location _____
 Rig up ☒
 Drilling and Remarks:

RECORD

Cased _____ in., _____ ft.
 Sand _____
 Gas _____
 Oil _____
 Total Depth _____

PRODUCTION

1st 24 hrs. Nat. _____
 1st 24 hrs. after shot _____
 Gas _____ Cu. Ft.
 Dry Hole _____
 Abandoned _____

Date

MAR 3 1926

CHAS. L. SHERWOOD

192

Scout

K2 KANSAS *Cowley*
 Map No. *19* Sec. *32* Twp. *5* R. *5*

Well No. *4* *Boyd*

Ingham *et al* Company

Contractor

COMPLETED

SECTION PLAT

1070 Ft. from N. Line

_____ Ft. from S. Line

_____ Ft. from E. Line

250 Ft. from W. Line

<i>0</i>			

Location _____

Rig up _____

Drilling and Remarks:

100 Bbl oil

20 Bbl water

Natural.

RECORD

Cased _____ in. _____ ft.

Sand *3006-3031'*

Gas _____

Oil _____

Total Depth *3067'*

PRODUCTION

1st 24 hrs. Nat. _____

1st 24 hrs. after shot _____

Gas _____ Cu. Ft.

Dry Hole _____

Abandoned _____

Date

JUN 2 1926

192

CHAS. L. SHERWOOD

Scout