KANSAS

FORM 51 25M 3-49 PETROL

Barton

Section 19 Township 16 Range 11W

Well No. 5 Redetzke

Company Brunson Drlg.

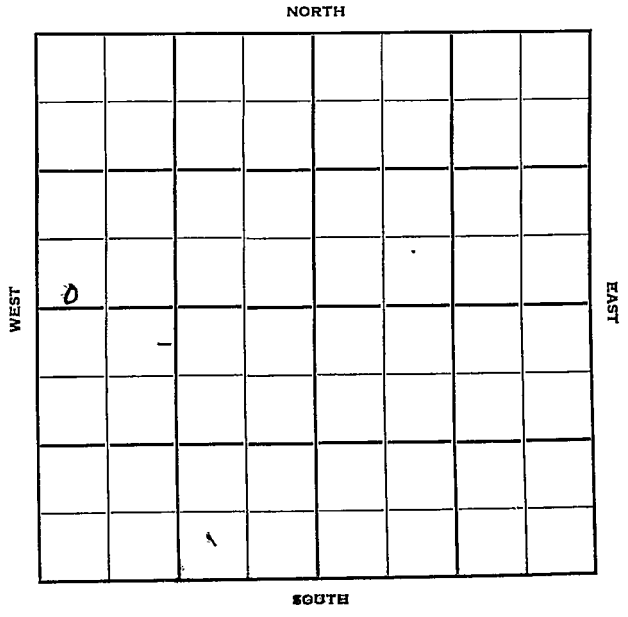

FORM 252-B

Barton KANSAS ✓

Sec. 19 Twp. 16 R. 11 W

Well No. # 5 Redetzke Farm

Brunson Drlg. Company

Pam-Kar Contractor

____ Ft. from N. Line

330 Ft. from S. Line

____ Ft. from E. Line

330 Ft. from W. Line

SW SW NW

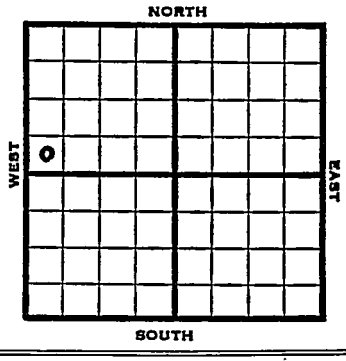

1952	Elev. 1899' REPORT
12/17	Spud 12-10-52 8" @ 333 Anhy 764' Drlg. 2850'
12/25	" "
1/1	Lans 3076 BKC 3270 Cong 3333 SD 3348 TD 3353 5" @ 3350
1/8	RUST
1/22	CO 3353' S/2 BO plus 1½ BWPH Hyd S/2 BOPH plus lot wtr. DD 3417' TD
1/29	NR
2/5	NR
2/12	NR
2/19	NR
2/26	"
3/12	NR
3/19	# 3 BOPH
3/26	NR
4/2	NR
4/9	"
4/16	NR
4/23	NR
4/30	"
5/7	"

OVER

1953

5/21 NR

5/28 "

6/24 NR

7/1 "

7/8 "

7/22 "

7/29 "

8/12 "

8/19 Spud 12-10-52 Oil well TD 3417
8" @ 333 Anhy 764 Tor 2986
Br lime 3060 Lans 3076 B KC 3270
Cong 3333 Sd 3348
DST 3324-53 open 1 hr rec 30' OCM
60' mud & SO TD 3353 5" @ 3350
CO to 3353 S/2 BO 1½ BWPH Hydro
S/2 BOPH DD 3417 PB 3355 2 BOPH
Comp. 25 BOPD

COMPLETED

FORM 275 FOR SALE BY KANSAS BLUE PRINT CO

County Barton State Kansas

Sec. 19 (Blk. / Twp.) 16 (Sur. / Rge.) 11W Map No.

Operator Brunson Drlg.

Well No. 5 Farm Redetzke

Elev. Location SW SW NW

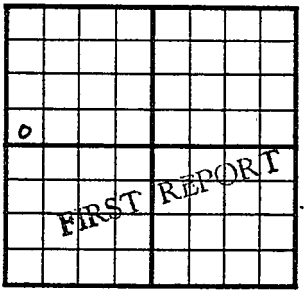

330 Ft. From S Line NW

330 Ft. From W Line Quarter

1st. Report DEC 17 1952

Completion

Remarks

Pam-Kar - Contr.

Spudding Date 12-10-52

Drlg. Data

8" @ 333 Anhy 764 drlg. 2850

J. G. McGEHEE

FORM 275 FOR SALE BY KANSAS BLUE PRINT CO.

County Barton State Kansas

Sec. 19 (Blk. Twp.) 16 (Sur. Rge.) 11W Map No.

Operator Brunson Drlg.

Well No. 5 Farm Redetzke

Elev. 1899 Location SW SW NW

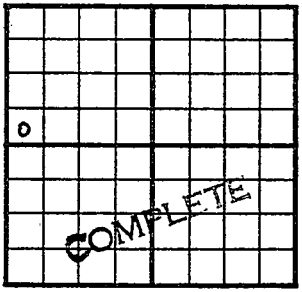

330 Ft. From S Line NW

330 Ft. From W Line Quarter

1st. Report

Completion AUG 19 1953

Remarks

Pam-Kar - Contr.

Spudding Date 12-10-52

Drlg. Data Oil well TD 3417

8" @ 333 Anhy 764 Tor. 2986

Br. lime 3060 Lans. 3076 B KC 3270

Cong. 3333 Sd. 3348 DST 3324-53

open 1 hr. Rec. 30' ocm 60' mud & so

TD 3353 5" @ 3350 CO to 3353

S/ 2 bo 1½ bwph Hydro. S/ 2 boph

DD 3417 PB 3355 2 boph

Comp. 25 bopd

J. G. McGEHEE