


Map No. **KANSAS** Sec. 19 Twp. 32 R. 5^E
 Well No. 1-Cawt Farm _____
Century Oil & Gas Company

_____ Ft. from N. Line
990 Ft. from S. Line
 _____ Ft. from E. Line
990 Ft. from W. Line

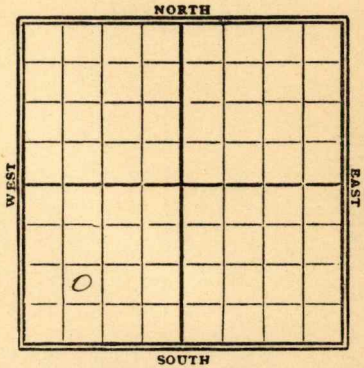

1929

Date	REPORT
11/13	Root
11/20	
11/27	Run up
12/4	Spdy
12/11	dry 460'
12/23	" 1410'
12/30	UIR 10"-1805'
1930	
1/8	dry 2250'
1/15	" 2280' 8"-2260'
1/22	" 2595'
1/29	" 2705'
2/5	sand 3093-95' dry T.D. 3140' dry & abandon

Caskey

2
Map No. **KANSAS** Sec. *19* Twp *32* R. *5^E*

Well No. *1* *Cavit*

Century Oil & Gas Co Company

Contractor

FIRST REPORTS

SECTION PLAT

..... Ft. from N. Line

990 Ft. from S. Line

..... Ft. from E. Line

990 Ft. from W. Line

Location.....

Rig up.....

Drilling and Remarks:

RECORD

Cased..... in., ft.

Sand.....

Gas.....

Oil.....

Total Depth.....

PRODUCTION

1st 24 hrs. Nat.....

1st 24 hrs. after shot.....

Gas..... Cu. Ft.

Dry Hole.....

Abandoned.....

Date

11/13/29

192.....

CHAS. L. SHERWOOD

Scout

Cowley

Map No. **2** **KANSAS** Sec. **19** Twp. **32** R. **5**

Well No. **1** **Cavit**

Century Oil Co Company

Contractor

COMPLETE

SECTION PLAT

..... Ft. from N. Line

990 Ft. from S. Line

..... Ft. from E. Line

990 Ft. from W. Line

0			

ABANDONED

Location.....

Rig up.....

Drilling and Remarks:

RECORD

Cased **3** in., ft.

Sand **3093-3095 Dry**

Gas.....

Oil.....

Total Depth **3140**

PRODUCTION

1st 24 hrs. Nat.....

1st 24 hrs. after shot.....

Gas..... Cu. Ft.

Dry Hole

Abandoned

Date

FEB 5 1930

CHAS. L. SHERWOOD

192..... Scout