


Map No. KANSAS Sec. 10 Twp. 25 R. 5^E

Well No. 1- Nettle Farm
July & Truck Company
 NORTH (Nettle)

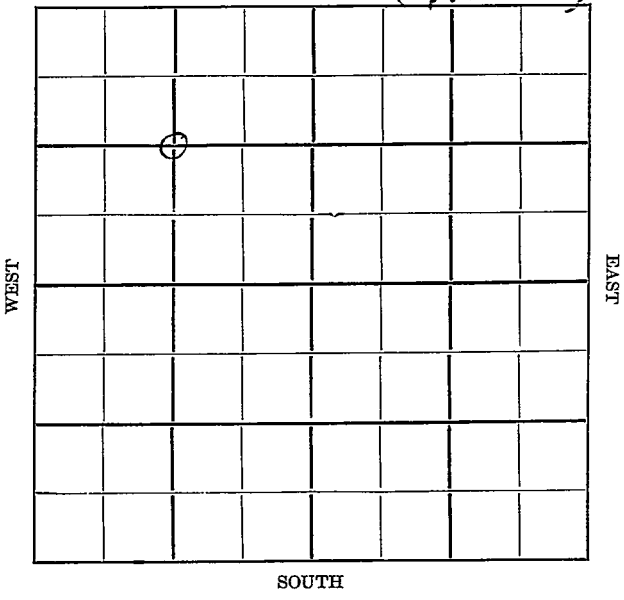

Location.....
 Drilling Remarks

Rig Up.....
 Drilling Remarks

RECORD

Cased..... in..... ft.
 Sand.....
 Gas.....
 Oil.....
 Total Depth.....

PRODUCTION

1st 24 hrs. Nat.....
 1st 24 hrs. after shot.....
 Gas..... cu. ft.....
 Dry Hole.....
 Abandoned.....

Butler

14 KANSAS
 Map No. _____ Sec. 10 Twp. 75 R. 5 ^{ET}

Well No. 1 *Mittler*

Kelly & Schreck Company

Contractor

FIRST REPORTS


1320 Ft. from N. Line

_____ Ft. from S. Line

_____ Ft. from E. Line

1320 Ft. from W. Line

SECTION PLAT

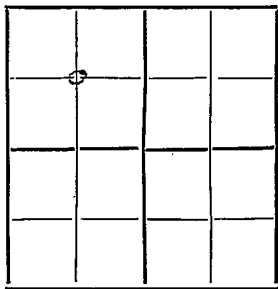

Location _____

Rig up *Apdy*

Drilling and Remarks:

RECORD

Cased _____ in., _____ ft.

Sand _____

Gas _____

Oil _____

Total Depth _____

PRODUCTION

1st 24 hrs. Nat. _____

1st 24 hrs. after shot _____

Gas _____ Cu. Ft.

Dry Hole _____

Abandoned _____

Date

MAY 29 1929

CHAS. L. SHERWOOD

192

Scout

Butler

Map No. 14 **KANSAS** Sec. 10 Twp. 25 R. 5

Well No. 1 Nuttle

Killey & Schreck Company

Contractor

COMPLETE

SECTION PLAT

1370 Ft. from N. Line

..... Ft. from S. Line

..... Ft. from E. Line

1370 Ft. from W. Line

Location.....

Rig up.....

Drilling and Remarks: ✓

5/10 B.S.

RECORD

Cased..... in., ft.

Sand 670-680

Gas.....

Oil.....

Total Depth 680

PRODUCTION

1st 24 hrs. Nat.....

1st 24 hrs. after shot.....

Gas..... Cu. Ft.

Dry Hole.....

Abandoned.....

Date

JUN 12 1929

CHAS. L. SHERWOOD