


10-25-5E

WELL LOG BUREAU KANSAS GEOLOGICAL SOCIETY  
412 Union National Bk. Bldg., Wichita, Kansas

Company - YUMA OIL CO.  
Farm Nuttle No. 4

SEC. 10 T. 25 R. 5 E  
NWc NW  
535' SNL 330' EWL NW $\frac{1}{4}$

Total Depth. 2694'  
Comm. 4-7-45 Comp. 5-9-45  
Shot or Treated.  
Contractor. Saco Oil Co.  
issued. 4-6-46

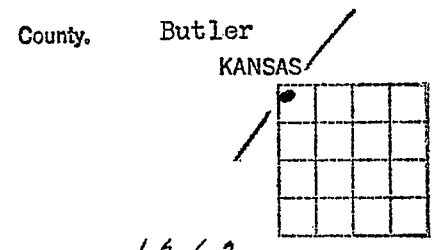

CASING:  
15" 125' 5" 2570'  
10" 1621'  
8" 2377'

Elevation. 1362

Production. Dry

Figures Indicate Bottom of Formations.

lime	50	lime	890	shale blk	2113
shale	60	shale	900	lime	2150
lime	109	shells & salt	905	sand drk	2165
shale drk	115	shale drk	928	lime	2172
shale lgt	121	lime	933	shale drk	2195
lime wh	126	shale	948	shale cvg	2240
shale blk	130	lime	953	shale	2250
lime	135	shale lgt	985	lime	2265
shale	140	lime	1005	shale lgt	2270
red rock	155	shale drk	1010	sand	2285
lime	195	shale lgt	1030	lime sdy	2297
shale	200	shale & shells	1070	shale	2330
red rock	210	lime	1077	lime	2370
slate	215	shale	1100	shale	2377
lime	225	lime	1135	lime	2378
slate drk	240	shale drk	1145	shale sdy	2430
slate lgt	250	lime	1155	shale & shells	2450
shale	260	shale lgt	1160	chat	2480
lime	270	shale drk	1170	shale drk	2485
shale lgt	300	lime	1175	shale lgt	2495
lime	305	lime drk	1195	shale drk	2500
shale drk	317	lime brkn	1215	lime	2504
lime	322	shale lgt	1220	shale lgt	2550
shale	335	lime sdy	1235	shale blk	2555
lime	342	slate	1250	shale drk	2566
shale	350	lime hrd	1260	lime	2585
slate	358	lime	1270	lime blk	2595
red rock	365	shale drk	1275	lime	2615
lime	383	shale lgt	1290	lime	2625
shale drk	390	lime	1300	sand	2663
lime	400	shale blk	1305	shale drk	2664
shale drk	405	lime	1355	sand	2673
lime	430	shale drk	1410	shale	2677
shale	440	lime	1420	sand & shale	2680
lime brkn	450	shale lgt	1425	shale gy	2690
slate lgt	460	lime sdy	1445	lime	2694
lime	475	lime	1455	Total Depth.	
shale drk	505	shale & shells	1470		
lime	520	lime	1485	Tops:	
shale	568	shale	1500	Lansing	1725
lime	578	lime	1512	K. C. Lime	2005
shale drk	595	shale drk	1522	Viola	2566
lime	600	shells & salt	1528	Wilcox	2615
shale	610	shale	1540	Arbuckle	2690
shale & salt	615	lime	1550		
slate blue	620	shale drk	1585	Water Record	
red rock	630	shale	1624	4 BWPB 85-95'	
shale lgt	660	lime	1650	1 BWPB 1335-50'	
shale sdy	680	shale lgt cvg	1665	2 BWPB 1540-50'	
shale drk	720	shale	1725	1 BWPB 1780-90'	
lime	725	lime hrd	1730	1 1/2 BWPB 2377'	
shells & salt	735	lime	1890	1 1/2 BWPB 2566-70'	
shale	745	shale	1930	HFW 2580-85'	
shale drk	798	lime	1945	HFW 2694'	
lime	835	shale drk	1950		
shale	850	shale lgt	1960	Oil & Gas Shows	
lime	875	shale sdy	1975	Show gas 1220-25'	
shale	885	shale	2005	Show gas 1506-12'	
				Show oil 2020-27'	

Small show oil 2270-76  
Little Stain 2566-70'  
w/1 1/2 BW

TM - 2140  
T 5 - 2595