

Section 10 Township 25 Range 5E
Well No. 5 Muttie (*Nuttie*)
Company Yuma Oil

0							

NORTH

WEST

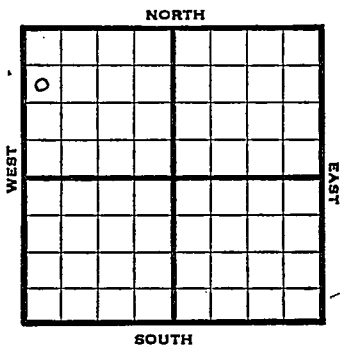
EAST

SOUTH

Sec. 10 Twp. 25 R. 5-EWell No. #5 Muttie FarmYuma Oil Company990 Ft. from N. Line

Ft. from S. Line

Ft. from E. Line

330 Ft. from W. Line

SW NW NW

1945 Elev. 1357 REPORT

11/21 15" @ 117'
TD 665'11/28 12" @ 792
Drlg. 125012/5 10" @ 1606
Lans 1700
C 1985

Drlg. 2000'

12/12 Peru 2225
8" @ 2311
Viola 2525
TD 2546 SO

12/20 7" - 2545' SO 500 acid.

12/29 Wilcox 2605-60' T.D.
Plugging back.

1946

1/10 " "

1/17 " "

1/24 7" - 2225' WOC.

1/30 Peru 2225
Viola 2525
7" @ 2225
40 qts. 2252-2267
TD 2660
Pump 50 Pot.
Grav. 38.0

COMPLETED

KANSASKansas Pool Name MiscellaneousMap No. 7 Sec. 10 Twp. 25 R. 5EWell No. 5 MuttieYuma Oil Company**FIRST REPORT**

Contractor

SW NW NW

SECTION PLAT990 Ft. from N. Line Ft. from S. Line Ft. from E. Line330 Ft. from W. Line

2			

Butler CountyLocation Rig up

Drilling and Remarks:

15" @ 117

665'

RECORDCased in., ft.Sand Gas Oil Total Depth **PRODUCTION**1st 24 hrs. Nat. 1st 24 hrs. after shot Gas Cu. Ft.Dry Hole Abandoned

Date

NOV 2 1 1945 19S. J. LEWIS Scout

KANSAS

Kansas Pool Name MiscellaneousMap No. 14 Sec. 10 Twp. 25 R. 5EWell No. 5 Nuttle• Yuma Oil Company

COMPLETED

Contractor

E. I. 1352

SW NW NW

SECTION PLAT

990 Ft. from N. Line Ft. from S. Line Ft. from E. Line330 Ft. from W. Line

Butler County

6			

Location Rig up

Drilling and Remarks:

Peru 2225Vista 25257" C 25254095-2252-67Pump .50 PD280 gr

RECORD

Cased in., ft.Sand Gas Oil Total Depth 2660

PRODUCTION

1st 24 hrs. Nat. 1st 24 hrs. after shot Gas Cu. Ft.Dry Hole Abandoned

Date

JAN 30 1946

19

S. I. LEWIS

Scout