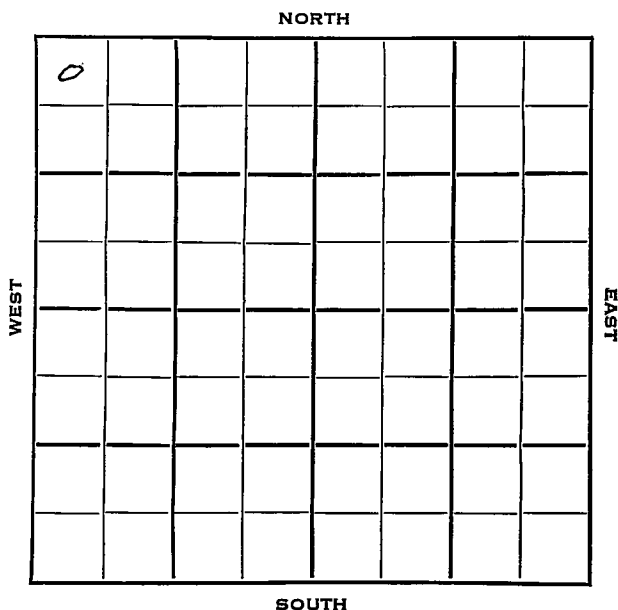


Section 11 Township 25 Range 5EWell No. #3 CameronCompany Saco Oil Company

Butler


Sec. 11 Twp. 25 R. 5EWell No. #3 Cameron FarmSaco Oil Company Company

Contractor

330 Ft. from N. Line

Ft. from S. Line

Ft. from E. Line

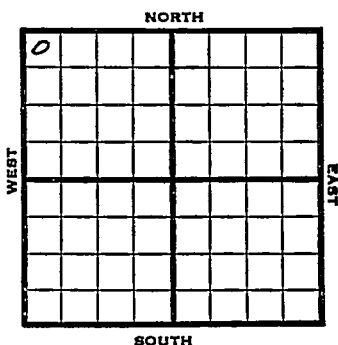330 Ft. from W. LineNW NW NW *3*

1953

Elev. 1332 REPORT

2/18

R U C T

3/25

Spud 2-16-53

Oil Well

TD 2251

13" @ 180

10" @ 280

Lans 1708, KC 1988, Prue 2239,

TD 2251

5" @ 2238

sd-frac Comp. 15 bopd

COMPLETED

County Butler State KansasSec. 11 (Blk.) 25 (Sur.) 5E Map No.Operator Saco OilWell No. 3 Farm CameronElev. Location NW NW NW

0							

330 Ft. From N Line NW330 Ft. From W Line Quarter1st. Report FEB 18 1953

Completion

Remarks

Spudding Date

Drlg. Data

R U C T

J. G. McGEHEE

County Butler State KansasSec. 11 (Blk.
Twp.) 25 (Sur.
Rge.) 5E Map No.Operator Saco OilWell No. 3 Farm Camer onElev. 1332 Location NW NW NW

0							

330 Ft. From N Line NW330 Ft. From W Line Quarter1st. ReportCompletion MAR 25 1953RemarksSpudding Date 2-16-53Drilg. Data Oil well TD 225113" @ 180 10" @ 780 Lans. 1708KC 1988 Prue 2239 TD 2251 5" @ 2238sd-frac Comp. 15 bopd

J. G. McGEHEE