

Cowley

FORM 51 5M BR1X

KANSAS

Section 18 Township 35 Range 3E

Well No. #1 H. W. Vickery

Company Hill & Hill

NORTH

		0					

SOUTH

WEST

EAST

3

Sec. **28** Twp. **35** R. **3E**

Well No. **#1 H. W. Vickery** Farm

Hill & Hill

Company


Miscellaneous

330 Ft. from N. Line

Ft. from S. Line

990 Ft. from E. Line

Ft. from W. Line

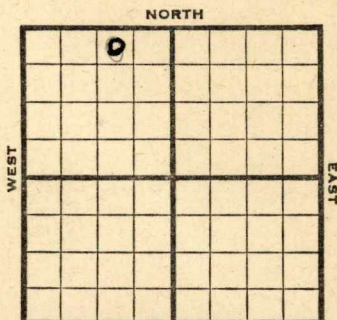

NW NE NW *Elev. 1181*

SOUTH

1944

R E P O R T

12/5	Derrick
12/14	"
12/21	"
12/29	"
1945	
1/3	"
1/10	RUR
1/17	10" @ 108 Drlg 1591
1/26	Drlg. 2435'
1/31	Drlg. 3020'
2/7	Bart 3412 7" @ 3386 RUST
2/14	7" @ 3409 TD 3421 CO
2/21	TD 3470 20 Qts 3444-66 CO
2/28	Swb 30 oil a day
3/7	" " " "
3/14	" " " "
3/23	" " " "

OVER

1945

3-28 Set 7" @ 3409'

Bartlesville 3412'

Total Depth 3470'

Shot 20 qts. 3444-66'

Pump 10 Potential.

Gravity 39.7

COMPLETED

Pool Name MiscellaneousMap No. 1 Sec. 18 Twp. 35 R. 3EWell No. 1 H. W. Vickery
Hill & Hill Company

FIRST REPORT

Contractor

NW NE NW

SECTION PLAT

330 Ft. from N. Line Ft. from S. Line990 Ft. from E. Line Ft. from W. Line

Cowley

Location Rig up

Drilling and Remarks:

derrick

RECORD

Cased in., ft.Sand Gas Oil Total Depth

PRODUCTION

1st 24 hrs. Nat. 1st 24 hrs. after shot Gas Cu. Ft.Dry Hole Abandoned

Date

DEC 6 1944

19

S. J. LEWIS

Scout

Pool Name MiscellaneousMap No. 1 Sec. 18 Twp. 35 R. 3EWell No. 1 H. W. VickeryHill & Hill

Company

COMPLETED

Contractor

NW NE NW

SECTION PLAT

330 Ft. from N. Line Ft. from S. Line990 Ft. from E. Line Ft. from W. Line

	0		

Cowley

Location Rig up

Drilling and Remarks:

*Bar 3412**7" @ 3429**209 to 3444-66**Pump 10 BX**35248*

RECORD

Cased in., ft.Sand Gas Oil Total Depth 3470

PRODUCTION

1st 24 hrs. Nat. 1st 24 hrs. after shot Gas Cu. Ft.Dry Hole Abandoned

Date

MAR / 28 1945

19

S. J. LEWIS

Scout