
FORM 51 Barton

KANSAS

Section 19 Township 16 Range 11W

Well No. #6 Redetzke

Company Gulf Oil Company

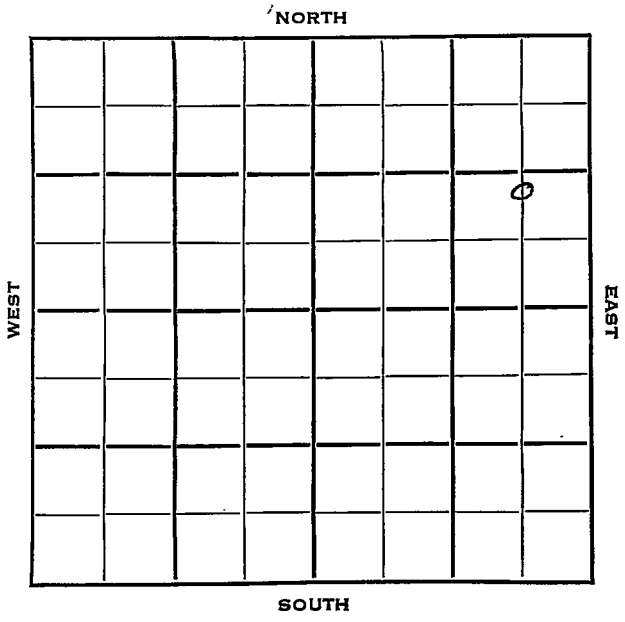

FORM 252-B Barton KANSAS

Sec. 19 Twp. 16 R. 11W

Well No. #6 Redetzke Farm

Gulf Oil Company Company

Contractor


Ft. from N. Line

990 Ft. from S. Line

660 Ft. from E. Line

Ft. from W. Line

C N L SE NE

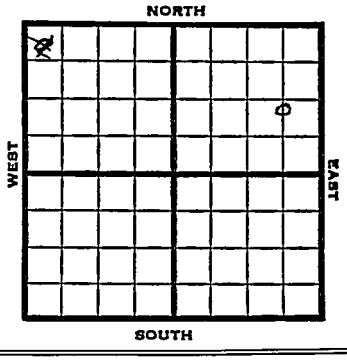

1953	Elev. 1902' REPORT
3/4	Spudded 2/26/53 Drlg. 560
3/12	Anhy 764' 8" @ 773 Heeb 2953' Br li 3049' Lans 3068' DST 3239-57, 1 hr, 30' O & GCM 225# Arb. 3331' RTD 3334' Schl 5" @ 3332'
3/19	CO 3334' 200 A S/3-1/3 BOPH 4 hrs. DD 3329' TD S/32½ BO 11 hrs.
3/26	NR
4/2	NR
4/8	Spud 2-26-53 Oil Well TD 3329' Anhy 764 8" @ 773' Heeb 2953, Br. Lime 3049, Lans 3068, DST 3239-57 open 1 hr. Rec 30' o & gcm 225# Arb 3331 TD 3334 5" @ 3332' CO to 3334 200 A S/ 3 1/3 boph 4 hr. DD 3329 S/ 32½ bo 11 hr. Comp. 66 bopd

COMPLETED

1953

Information brought forward

COMPLETED

FORM 275 FOR SALE BY KANSAS BLUE PRINT CO.


County Barton State Kansas

Sec. 19 (Blk. Twp.) 16 (Sur. Rge.) 11W Map No.

Operator Gulf Oil

Well No. 6 Farm Redetzke

Elev. Location C N L SE NE

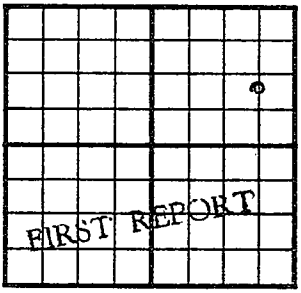

990 Ft. From S Line NE

660 Ft. From E Line Quarter

1st. Report MAR 4 1953

Completion

Remarks

Spudding Date 2-26-53

Drlg. Data

drlg. 560

J. G. McGEHEE

FORM 275 FOR SALE BY KANSAS BLUE PRINT CO.


County Barton State Kansas

Sec. 19 (Blk. Twp.) 16 (Sur. Rge.) 11W Map No.

Operator Gulf Oil

Well No. 6 Farm Redetzke

Elev. 1902 Location C N L SE NE

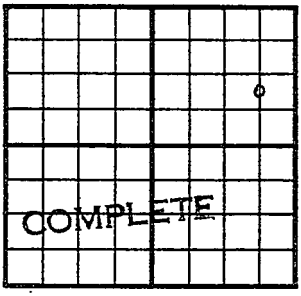

990 Ft. From S Line NE

660 Ft. From E Line Quarter

1st. Report

Completion APR 8 1953

Remarks

Spudding Date 2-26-53

Drlg. Data Oil well TD 3329

Anhy 764 8" @ 773 Heeb. 2953

Br. lime 3049 Lans. 3068 DST 3239-57

open 1 hr. Rec. 30' o & gcm 225#

Arb. 3331 TD 3334 5" @ 3332 CO to 3334

200 A S/ 3 1/3 boph 4 hr. DD 3329

S/ 32½ bo 11 hr. Comp. 66 bopd

J. G. McGEHEE