Barton


KANSAS

SECTION 19 TOWNSHIP 16S RANGE 11W

WELL NO. #9 Redetzke

COMPANY Gulf

NORTH C S/2 N/2 NE

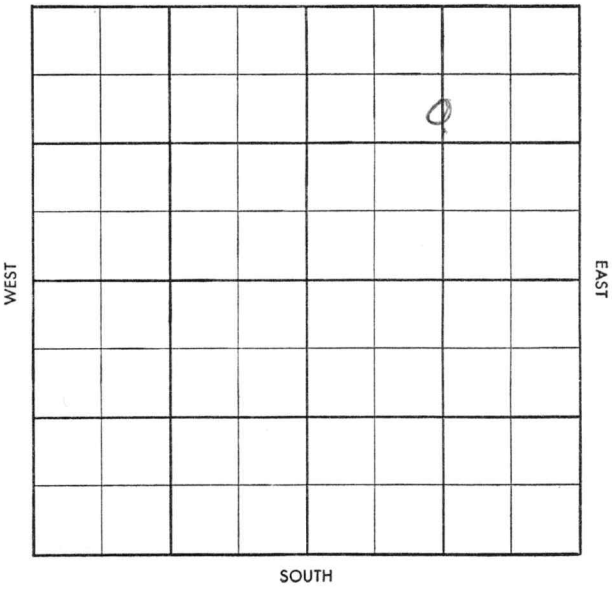

FORM 504-3 SUNRAY

Twp. NO Post NO

Gr. Post 45

S-513-B

County Barton Elev.

Sec. 19 Twp. 16 Rge. 11W

Company Gulf

Farm Name Redetzke No. 9

TOPS	DEPTH	LOG	DATUM
Anh.			
Tp.			
H.			
Tr.			
Dg.			
B. L.			
L.			
K.C.			
B.K.C.			
Ce.			
C.			
M.			
M.			
K.			
Mz.			
Mq.			
V.			
S.			
S.			
A.			
R.			
Pf.			
G.			
T.D.			

Loc. in Sec. C S/2 N/2 N

Geol.

Contr. Lewis Tools

Pool

PKST REPORT Aug 13

Date Comm. 8-2-58

8" 777/425 WOC

Twp. 16 Pool NB

Co. 2 Feet NB

S-513-B

13

County Barton Elev.

Sec. 19 Twp. 16 Rge. 11W

Company Gulf

Farm Name Hedetzke No. 9

TOPS	DEPTH	LOG	DATUM
Anh.			
Tp.			
H.	2954		
Tr.			
Dg. SH	2983		
B.L.	3044		
L.	3063		
K.C.			
B.K.C.			
Ce.			
C.			
M.			
M.			
K.			
Mz.			
Mq.			
V.			
S.			
S.			
A.	3328		
R.			
Pf.			
G.			
T.D.	3331		

Loc. in Sec. C S/2 N/2 NE

Geol.

Contr. Lewis Tools

Pool Kraft-Prusa

SEP 3 '58

COMPLETE

Date Comm. 8-2-58

8th 777/425 WCO 3285 AUG 20 '58 log

5½" 3330 ½/100 CO 3331

$13 BO NW 1hr 530' OB

$112 hrs FV 2000' oil / NW

$6 BO gh NW 5 hrs 1800' OB to pool

AUG 27 '58 P 65 BO NoW 19½ hrs SEP 3 '58 P

152 BO NW 24 hrs

Co. Lse. No. Sec. T. R.