Barton KANSAS


19 16S 11W

SECTION TOWNSHIP RANGE

WELL NO. #7 A.A. Redetzke

COMPANY Gulf Oil Corp.

NORTH W/2 NE NE

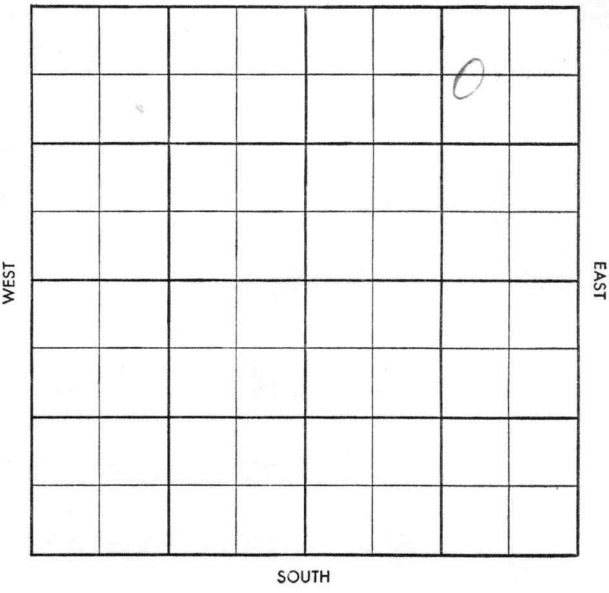

S-513-A

CO. Barton ELEV.

SEC. 19 TWP. 16 RGE. 11W

COMPANY Gulf Oil Corp NO. 7

FARM A. A. Redetzke

LOC. W/2 NE NE

GEOL.

CONTR. ~~Lewis Drlg. tools~~

POOL ~~Kraft-Prusa~~

SPUD 10-25-57

OCT 30 57

FIRST REPORT

CO. LSE. NO. SEC. TWP. RGE.

8" @ 770 w/375, Drlg. 1485 3150' L-KC test. Anhy. 765.

S-513-A

CO. Barton ELEV. 1909 DF 1912 KB

SEC. 19 TWP. 16 RGE. 11W

COMPANY Gulf Oil Corp. NO. 7

NOV 27 '57

COMPLETE

FARM A. A. Redetzke

LOC. W/2 NE NE

GEOL.

CONTR. Lewis Drlg. tools

POOL Kraft-Prusa

SPUD 10-25-57

CO. LSE. NO. SEC. TWP. RGE.

8" @ 770 w/375, Drlg. 1485 3150' L-KC test. Anhy. 765. NOV 6 '57 Hb 2959 TR 2976 B Ord 2988 B 13058 Lkc 3071 DST 3238-50 6' ocm ΘHP 600/25" TP 3315 Log Hb 2958 TR 2974 B Ord 2985 BL 3052 Lkc 3071 5½ = 3315/75 WOC NOV 13 '57 CO 3260 40/32 38-48 $ 1 BMW SI 30" B 790

SI 1 24hr B 20 go 1 sx hr B 18 go 2nd 250A 1500A POP NOV 20 '57 P 32 BO + 6 BW 9 hrs P 140 BO 15 BW 24 hrs Gr 36.6° CD Dly P 116 BO + 14 BW pd

TD 3315

Lkc 3238-48

allowable 25