

KANSAS

Barton


FORM 51 5M 1-42 PETROL

Section 20 Township 16 Range 11-W

Well No. #2 Esfeld

Company Texon et al

NORTH Prusa-Kraft Pool

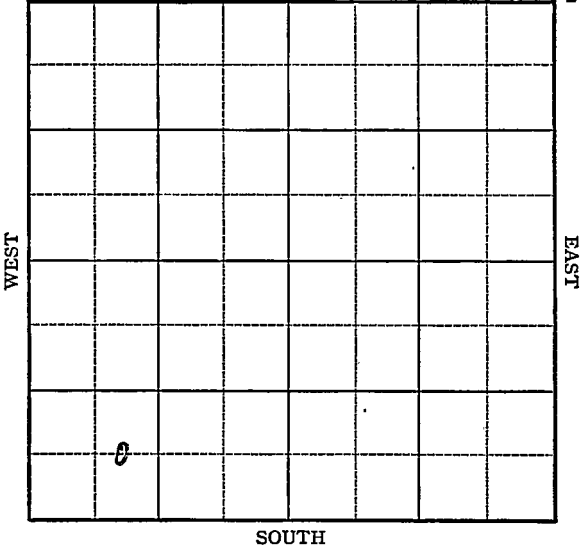

KANSAS


Barton

Sec. 20 Twp. 16 R. 11-WWell No. #2 Esfeld FarmTaxon et al Company

(Prusa-Kraft)

 Ft. from N. Line660 Ft. from S. Line Ft. from E. Line990 Ft. from W. Line

Elev. 1881

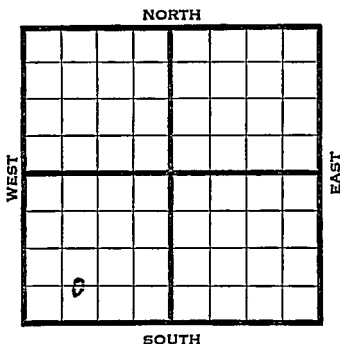

1942	REPORT
1/28'	Derrick.
2/5	10" - 205' Drlg. 856'
2/12	Drlg. 3309'
2/19	Lans. 3040' Sdy Cong. 3314' S.O.
	Quartzite 3323-25' T.D. 6" - 3313'
	RUST.
2/25	Cong. 3323' (Corrected)
	T.D. 3339' in Cong. 1700' oil.
	Run liner.
3/4	Lans. 3040'
	6" - 3313' 8
	Cong. 3323'
	T.D. 3339'
	26' of 4" perforated liner at 3339'
	Potential 140 bbls., pump.
	42.8 Gravity
	COMPLETED

Map No. 55 Sec. 20 Twp. 16 R. 11WWell No. 2 EsfeldTexon et al. CompanyFIRST REPORT Contractor

C EL SW SW

 Ft. from N. Line660 Ft. from S. Line Ft. from E. Line990 Ft. from W. Line

SECTION PLAT

PRUSA-KRAFT POOL

Location Rig up

Drilling and Remarks:

Derrick

RECORD

Cased in., ft.Sand Gas Oil Total Depth

PRODUCTION

1st 24 hrs. Nat. 1st 24 hrs. after shot Gas Cu. Ft.Dry Hole Abandoned

Date

JAN 28 1942 19 S. L. LEWIS Scout

KANSAS

Barton

Map No. 55 Sec. 20 Twp. 16 R. 11WWell No. 2 Esfeld

Texon etal.

Company

COMPLETED

Contractor

C EL SW SW

SECTION PLAT

Ft. from N. Line

660 Ft. from S. Line

Ft. from E. Line

990 Ft. from W. Line

PRUSA-KRAFT POOL

Location _____

Rig up _____

Drilling and Remarks:

*Loss 3040**6" C C 3313**Prod 3323**26" 4" Pex. Line**a 3339**Pump 140 Pex.**42 E Gr***RECORD**

Cased _____ in., _____ ft.

Sand _____

Gas _____

Oil _____

Total Depth 3339**PRODUCTION**

1st 24 hrs. Nat. _____

1st 24 hrs. after shot _____

Gas _____ Cu. Ft.

Dry Hole _____

Abandoned A

Date

MAR 4 1942 19

S. J. LEWIS Scout