DX 78-1


KANSAS

Barton

Section 20 Township 16 Range 11 W

Well No. # 2 Esfeld

Company L. C. Knight

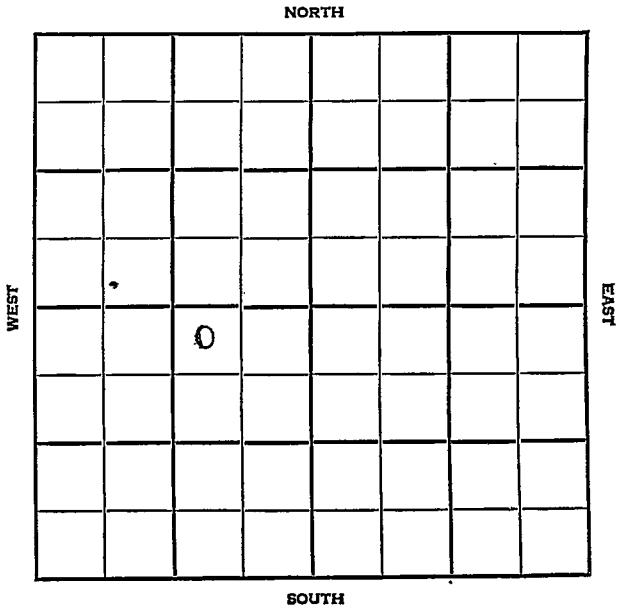

Barton KANSAS

| SEC. | TWP. | R. |
|---|---|---|
| 20 | 16 | 11 W |

WELL NO.

# 2 Esfeld FARM

COMPANY

L. C. Knight

CONTRACTOR

Co. tools


Kraft-Prusa Pool

330 Ft. from N. Line

Ft. from S. Line

990 Ft. from E. Line

Ft. from W. Line

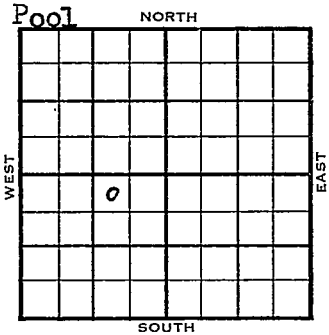


NW NE SW
Continental F/0

ELEVATION 1867'

| 1954 | REPORT |
|---|---|
| 8/11 | Spud 8-5-54<br>8" @ 270<br>Drlg. 1885' |
| 9/29 | Spud 8-5-54<br>Oil Well<br>TD 3015'<br>8" @ 270'<br>Doug. 2958'<br>TD 3015'<br>5" @ 3015'<br>25/2961-64; frac.<br>Heeb 2913', Doug 2959'<br>S/18 boph 2 hrs.<br>P/5 boph<br>Comp. 120 bopd |

COMPLETED

DX-78

FORM 275 FOR SALE BY KANSAS BLUE PRINT CO.


County Barton State Kansas

Sec. 20 (Blk. Twp.) 16 (Sur. Rge.) 11W Map No.

Operator L. C. Knight

Well No. 2 Farm Esfeld

Elev. Location NW NE SW

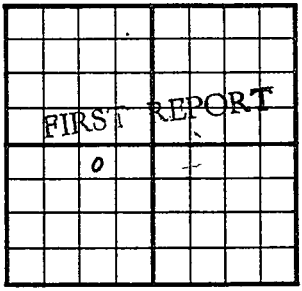


330 Ft. From N Line SW

990 Ft. From E Line Quarter

1st. Report AUG 11 1954

Completion

Remarks Continental FO
Co. tools

Spudding Date 8-5-54

Drlg. Data Kraft-Prusa Pool

8" @ 270 drlg. 1885

7 S

FORM 275 FOR SALE BY KANSAS BLUE PRINT CO.


County Barton State Kansas

Sec. 20 (Blk. Twp.) 16 (Sur. Rge.) 11W Map No.

Operator L. C. Knight

Well No. 2 Farm Esfeld

Elev. 1867 Location NW NE SW

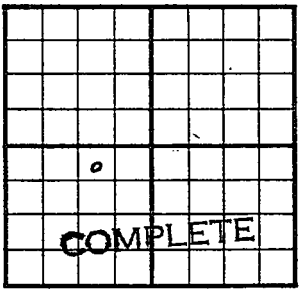


330 Ft. From N Line SW

990 Ft. From E Line Quarter

Ist. Report Aug 11 1954

Completion SEP 29 1954

Remarks Continental FO Co. Tools

Spudding Date 8-5-54

Drlg. Data Oil well TD 3015 Kraft-Prusa Pool

8" @ 270 Doug. 2958 TD 3015 5" @ 3015

25/ 2961-64 frac Heeb. 2913 Doug. 2959

S/ 18 boph 2 hr. P/ 5 boph

Comp. 120 bopd

FABEN GILSTRAP