


Section 15 Township 25 Range 5E

Well No. 1 Nuttle

Company J. Schoemaker et al

Misc.

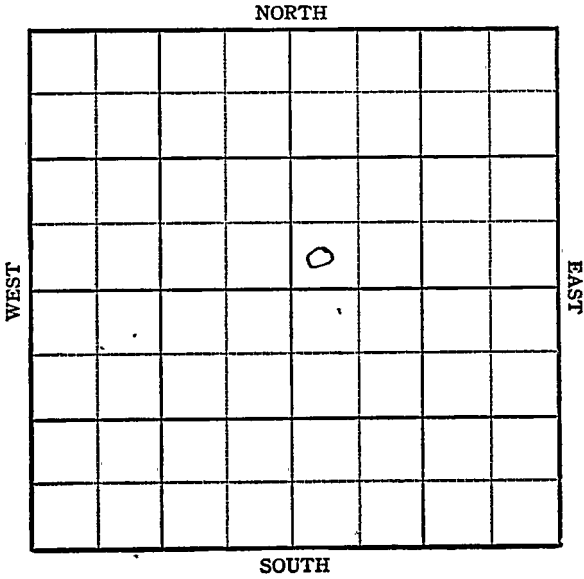

Sec. 15 Twp. 25 R. 5E ✓

Well No. #1 Nuttles Farm

J. Schoemaker et al Company

Miscellaneous


\_\_\_\_\_ Ft. from N. Line

400' Ft. from S. Line

\_\_\_\_\_ Ft. from E. Line

400' Ft. from W. Line

SW NE

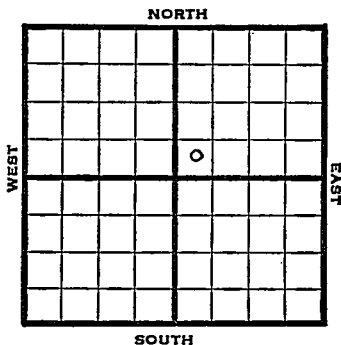

1948 Elev. 1320' REPORT

9/15 15" @ 112'  
Drlg. 175'

9/21 Drlg. 1083'

9/29 13" @ 835'  
10" @ 1770'  
Drlg. 1880'

10/6 Drlg. 2368'

10/13 Viola 2548'  
5" @ 2548'  
Pump 200 oil Pot.  
Gr. 39°  
TD 2551'

**COMPLETED**

Butler County Kansas State


Map No. Sec. 15 Twp. 25 R. 5E

Well No. 1 Nuttles

J. Schoemaker et al. Company

SW NE FIRST REPORT Contractor

SECTION PLAT

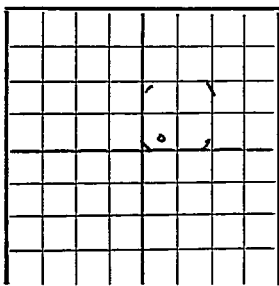

Ft. from N. Line

400 Ft. from S. Line

Ft. from E. Line

400 Ft. from W. Line

Miscellaneous

Remarks:

15" @ 112 drlg. 175

Date SEP 15 1948

Scout S. J. LEWIS

Map No. 14 Sec. 15 Twp. 25 R. 5E

Well No. 1 Nuttles

J. Schoemake et al. Company

COMPLETE Contractor

SW NE

E 1/4 320  
SECTION PLAT

         Ft. from N. Line

400 Ft. from S. Line

         Ft. from E. Line

400 Ft. from W. Line


Butler County

RECORD

Location \_\_\_\_\_

Rig up \_\_\_\_\_

Drilling and Remarks:

*Vid 2548*  
*5" @ 2548*  
*Pump 200 oil test*

*89° S*

Cased \_\_\_\_\_ in., \_\_\_\_\_ ft.

Sand \_\_\_\_\_

Gas \_\_\_\_\_

Oil  \_\_\_\_\_

Total Depth 2551

PRODUCTION

1st 24 hrs. Nat. \_\_\_\_\_

1st 24 hrs. after shot \_\_\_\_\_

Gas \_\_\_\_\_ Cu. Ft.

Dry Hole \_\_\_\_\_

Abandoned \_\_\_\_\_

Date

OCT 13 1948 19

S. J. LEWIS Scout