

KANSAS


FORM 51 5M 1-42 PETROL

Butler

Section 16 Township 25 Range 5E

Well No. #19 Robinson

Company Deep Rock

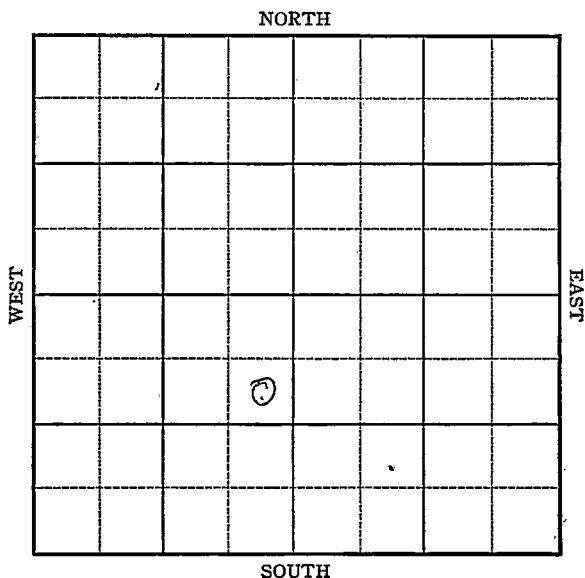

Butler

Sec. 16 Twp. 25 R. 5E

Well No. #19 Robinson Farm

Deep Rock Company

Miscellaneous


990 Ft. from N. Line

 Ft. from S. Line

330 Ft. from E. Line

 Ft. from W. Line

Elev. 1365

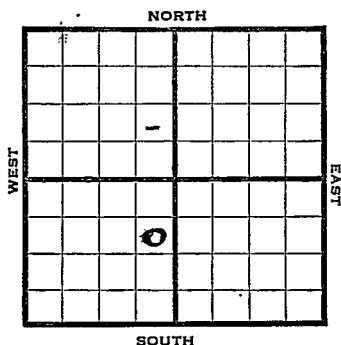

1944

REPORT

4/26	Location
5/3	"
5/10	"
5/17	"
5/24	"
5/31	15" @ 100 Drlg.
6/7	12" @ 795 Drlg. 1190'
6/15	10" @ 1550 8" @ 2040 Drlg. 2070
6/21	Viola 2480 5" @ 2470 TD 2484 500 acid
6/28	5" @ 2470 Viola 2480 TD 2484 500 acid Pump 60 Pot.


Gravity 38.0

COMPLETED

Pool Name MiscellaneousKANSAS, 4
Map No. _____ Sec. 16 Twp. 25 R. 5EWell No. 19 RobinsonDeep Rock CompanyFIRST REPORT Contractor

SE NE SW

SECTION PLAT

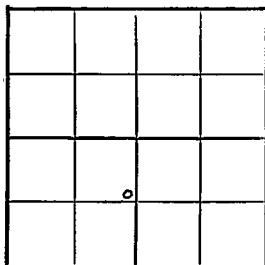990 Ft. from N. Line

_____ Ft. from S. Line

330 Ft. from E. Line

_____ Ft. from W. Line

Butler CountyLocation X

Rig up _____

Drilling and Remarks:

RECORD

Cased _____ in., _____ ft.

Sand _____

Gas _____

Oil _____

Total Depth _____

PRODUCTION

1st 24 hrs. Nat. _____

1st 24 hrs. after shot _____

Gas _____ Cu. Ft.

Dry Hole _____

Abandoned _____

Date

APR 26 1944 19S. J. LEWIS Scout

KANSAS

Pool Name MiscellaneousMap No. 4 Sec. 16 Twp. 25 R. 5EWell No. 19 RobinsonDeep Rock

Company

COMPLETED

Contractor

SE NE SW


SECTION PLAT

990 Ft. from N. Line

Ft. from S. Line

330 Ft. from E. Line

Ft. from W. Line

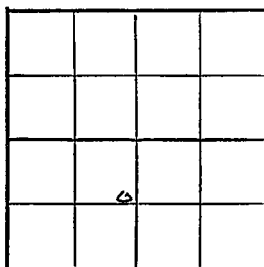Butler County

Location

Rig up

Drilling and Remarks:

*Viola 2480**5" @ 2470**500 acid**Pump 600 ft**38° E*

RECORD

Cased _____ in., _____ ft.

Sand _____

Gas _____

Oil _____

Total Depth 2484

PRODUCTION

1st 24 hrs. Nat. _____

1st 24 hrs. after shot _____

Gas _____ Cu. Ft.

Dry Hole _____

Abandoned _____

Date

JUN 2 '8 194419S. J. LEWIS Scout