


Butler

Section 16 Township 25 Range 5E

Well No. <sup>18</sup>~~40~~ Robinson

Company Deep Rock

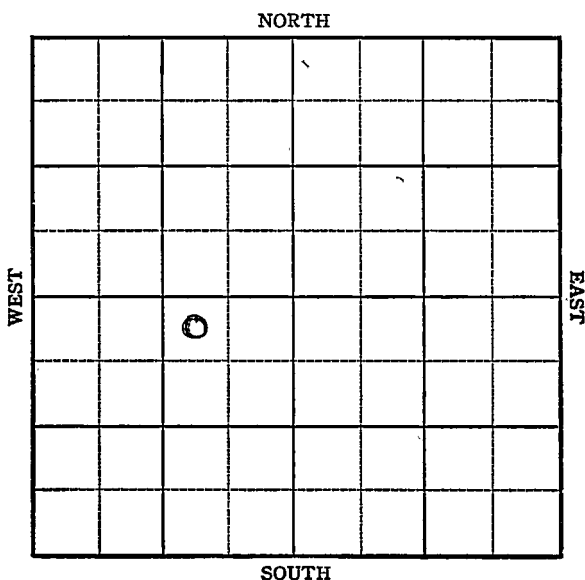

Sec. 16 Twp. 25 R. 5E

Well No. #18 ~~#48~~ Robinson Farm

Deep Rock Company


Miscellaneous

330 Ft. from N. Line

         Ft. from S. Line

990 Ft. from E. Line

         Ft. from W. Line

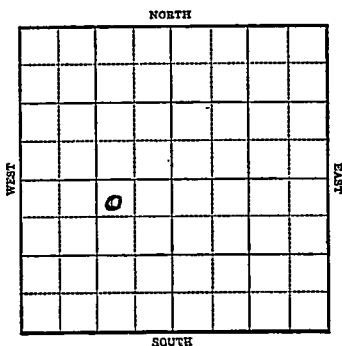

1944

R E P O R T

3/8 Cellar

3/16 Drilling 525

3/22 Drlg. 1260  
12" @ 850

3/29 10" @ 1590  
Lans 1712  
Drlg. 1970  
S.S.O

4/5 Miss 2430-32 RD SO  
7" @ 2430  
Rust.

4/12 7" @ 2430  
Viola 2496  
TD 2500  
Miss 2430  
Pump 50 Pot.  
Gravity 38

COMPLETED

ANSAS

Map No. 14 Sec. 16 Twp. 25 R. 5EWell No. 48 RobinsonDeep Rock

Company

## FIRST REPORT

Contractor

NW NE SW

330

Ft. from N. Line

Ft. from S. Line

990

Ft. from E. Line

Ft. from W. Line

## SECTION PLAT

|  |   |  |  |
|--|---|--|--|
|  |   |  |  |
|  |   |  |  |
|  | o |  |  |
|  |   |  |  |

## Miscellaneous

Location

Rig up

Drilling and Remarks:

Cellar

## RECORD

Cased \_\_\_\_\_ in., \_\_\_\_\_ ft.

Sand \_\_\_\_\_

Gas \_\_\_\_\_

Oil \_\_\_\_\_

Total Depth \_\_\_\_\_

## PRODUCTION

1st 24 hrs. Nat. \_\_\_\_\_

1st 24 hrs. after shot \_\_\_\_\_

Gas \_\_\_\_\_ Cu. Ft.

Dry Hole \_\_\_\_\_

Abandoned \_\_\_\_\_

Date

MAR 8 1944 19

S. J. LEWIS Scout

KANSAS/

Map No. 14 Sec. 16 Twp. 25 R. 5EWell No. 18 RobinsonDeep Rock

Company

CORRECTION

Contractor

NW NE SW

## SECTION PLAT

330 Ft. from N. Line

Ft. from S. Line

990 Ft. from E. Line

Ft. from W. Line

|  |   |  |  |
|--|---|--|--|
|  |   |  |  |
|  |   |  |  |
|  | o |  |  |
|  |   |  |  |

## Miscellaneous

Location

Rig up

Drilling and Remarks:

Reported as  
#48 Robinson

## RECORD

Cased \_\_\_\_\_ in., \_\_\_\_\_ ft.

Sand \_\_\_\_\_

Gas \_\_\_\_\_

Oil \_\_\_\_\_

Total Depth \_\_\_\_\_

## PRODUCTION

1st 24 hrs. Nat. \_\_\_\_\_

1st 24 hrs. after shot \_\_\_\_\_

Gas \_\_\_\_\_ Cu. Ft.

Dry Hole \_\_\_\_\_

Abandoned \_\_\_\_\_

Date

MAR 15 1944 19

S. J. LEWIS Scout

KANSAS

Map No. 14 Sec. 16 Twp. 25 R. 5EWell No. 18 RobinsonDeep Rock Company

COMPLETED

Contractor

NW NE SW

## SECTION PLAT

|  |   |  |  |
|--|---|--|--|
|  |   |  |  |
|  |   |  |  |
|  | o |  |  |
|  |   |  |  |

330 Ft. from N. Line       Ft. from S. Line990 Ft. from E. Line       Ft. from W. Line

## Miscellaneous

Location                                 Rig up                                 

Drilling and Remarks:

*Viola 2496**7" 2430**Viola 2430**Pump 50 P.D.**35 SE*

## RECORD

Cased            in.,            ft.Sand                                 Gas                                 Oil                                 Total Depth 2500

## PRODUCTION

1st 24 hrs. Nat.                                 1st 24 hrs. after shot                                 Gas                                  Cu. Ft.Dry Hole                                 Abandoned                                 

Date

APR 12 1944 '19

S. I. LEWIS Scout