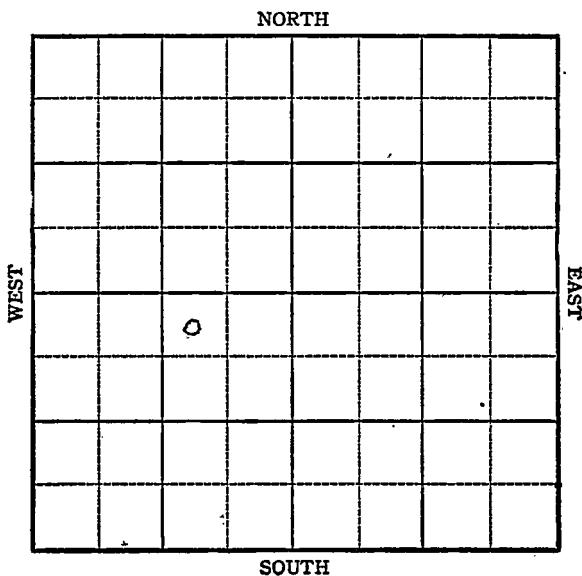


KANSAS

Butler County

Section 16 Township 25 Range 5EWell No. 20 RobinsonCompany Deep Rock

KANSAS

Butler

Sec. 16 Twp. 25 R. 5E

Well No. #20 Robinson Farm

Deep Rock Company


Miscellaneous

330' Ft. from N. Line

Ft. from S. Line

900' Ft. from E. Line

Ft. from W. Line

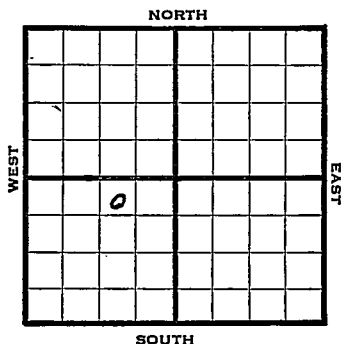

1944

REPORT

6/28 R O G
7/12 Drlg 1335
7/19 Drlg 2150
7/26 8" @ 2075 - 5" @ 2446
8/2 KC 1965'
TD 2490
8/9 Viola 2438
Simp.sd 2482
2492 NR 5"
8/16 5" @ 2557-2555 Drlg.
8/23 Simp Sd 2482
5" @ 2557
TD 2580
Imput 30 wtr per hr
SWD

ABANDONED

Pool Name MiscellaneousMap No. KANSAS Sec. 16 Twp. 25 R. 5EWell No. 20 RobinsonDeep Rock CompanyFIRST REPORT Contractor

NW NE SW

SECTION PLAT

330 Ft. from N. Line Ft. from S. Line990 Ft. from E. Line Ft. from W. Line

	0		.

Butler CountyLocation Rig up

Drilling and Remarks:

R. O. G.

RECORD

Cased in., ft.Sand Gas Oil Total Depth

PRODUCTION

1st 24 hrs. Nat. 1st 24 hrs. after shot Gas Cu. Ft.Dry Hole Abandoned

Date

JUN 28 1944 19S. J. LEWIS Scout

Pool Name MiscellaneousMap No. 14 Sec. 16 Twp. 25 R. 5EWell No. 20 RobinsonDeep Rock Company**ABANDONED**

Contractor

NW NE SW

SECTION PLAT

	0		

330 Ft. from N. Line Ft. from S. Line990 Ft. from E. Line Ft. from W. LineButler CountyLocation Rig up

Drilling and Remarks:

*Imp. Sol. 2482**516 @ 2557**Imp. u & 30 Water**Per Mr**SWJ***RECORD**Cased in., ft.Sand Gas Oil Total Depth 2580**PRODUCTION**1st 24 hrs. Nat. 1st 24 hrs. after shot Gas Cu. Ft.Dry Hole Abandoned

Date

AUG 23 1944 19S. J. LEWIS Scout