

INCAS


Barton

FORM 51 5M PETROL

Section 20 Township 16 Range 11-W

Well No. #3 J. G. Einfeld

Company Texon

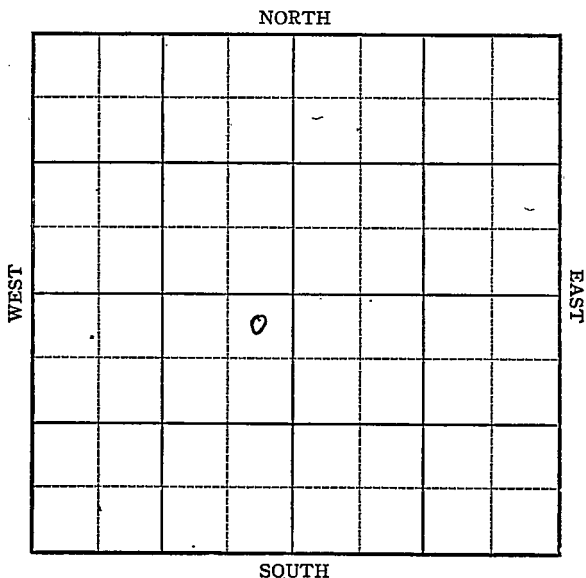

Sec. 20 Twp. 16 R. 11-W

Well No. #3 J. G. Esfeld Farm

Texon Company


330 Ft. from N. Line

_____ Ft. from S. Line

330 Ft. from E. Line

_____ Ft. from W. Line

Elev. 1870

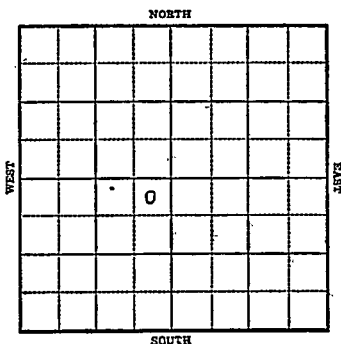

1943

R E P O R T

10/13 Location

10/20 "

10/27 "

11/3 "

11/10 10" @ 240
WOC

11/17 2780 fsg.

11/24 Lans 3022
Arb 3323-28 TD
7" @ 3323

RUST

12/15 7" @ 3323
Arb 3323
Pump 528 Pot.
TD 3328
Grav. 42.3

COMPLETED

KANSASMap No. 55 Sec. 20 Twp. 16 R. 11WWell No. S J. G. Esfeld

Texon

Company

FIRST REPORT

Contractor

NE SW

SECTION PLAT

330 Ft. from N. Line Ft. from S. Line330 Ft. from E. Line Ft. from W. Line

		o	

Kraft Prusa PoolLocation XRig up

Drilling and Remarks:

RECORD

Cased in., ft.Sand Gas Oil Total Depth

PRODUCTION

1st 24 hrs. Nat. 1st 24 hrs. after shot Gas Cu. Ft.Dry Hole Abandoned

Date

OCT 13 1943 19S. J. LEWIS Scout

