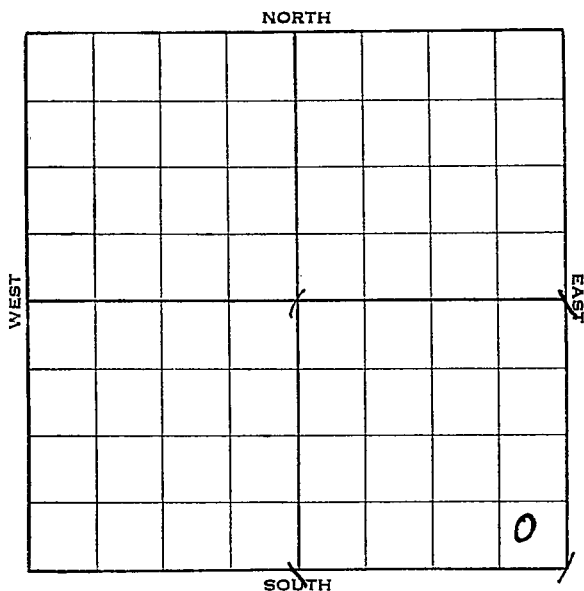


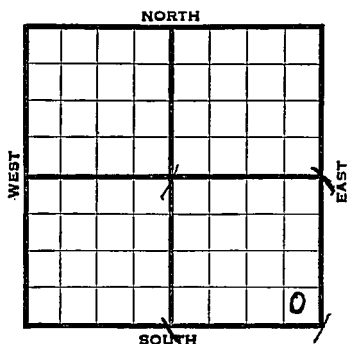
KANSAS

Barton

Section 20 Township 16 Range 11-WWell No. #1 PrusaCompany Sinclair-Prairie et al

KANSAS

Barton

Sec. 20 Twp. 16 R. 11-WWell No. #1 Prusa FarmSinclair-Prairie et al Company Ft. from N. Line440 Ft. from S. Line440 Ft. from E. Line Ft. from W. LineElev. 1914'.

1938	REPORT
11/9	B.R.R.
11/18	13" - 356'. WOC.
11/25	Anhy. ⁷⁶⁶ 755 ' - Dlg. - 2525'.
12/2	Anhy 766' (Corrected)
	Fort Riley 1711'.
	S.S.O. 3057-62'. Lans. 3071'.
	S.S.O. 3083-86'. Arb. 3335'.
	T. D. 3352'. S. O. in cuttings.
	Running 8".
12/9	7" - 3334'. Drilled plug.
	1100' oil 1½ hrs. 3000' oil 3 hrs. Gravity 42 at 57'.
12/13	7" - 3334'.
	Arb. 3335'.
	T. D. 3352'.
	Pump 438 bbls. 8 hours.
	Potential 1313 bbls. natural.
	Gravity 42 / 57
	COMPLETED

Barton KANSAS

Map No. 55 Sec. 20 Twp. 16 R. 11WWell No. 1 PrusaSinclair Prairie etal Company

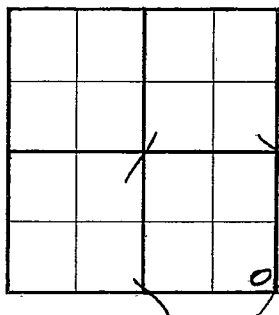
Contractor

FIRST REPORT

SE/C

 Ft. from N. Line440 Ft. from S. Line440 Ft. from E. Line Ft. from W. Line

SECTION PLAT

Location Rig up

Drilling and Remarks:

BRR

RECORD

Cased in., ft.Sand Gas Oil Total Depth

PRODUCTION

1st 24 hrs. Nat. 1st 24 hrs. after shot Gas Cu. Ft.Dry Hole Abandoned

Date

Nov 4 - 1938 19

H. D. Hatfield

Scout

Barton

KANSAS

Map No. 53 Sec. 20 Twp. 16 R. 11WWell No. 1 PrusaSinclair Prairie etal Company

Contractor

COMPLETED

SE/C

SECTION PLAT

 Ft. from N. Line440 Ft. from S. Line440 Ft. from E. Line Ft. from W. LineLocation Rig up

Drilling and Remarks:

Pump #38/8

ROT 1313

NAT

gran 42/57

RECORD

Cased 7 in. 3334 ft.Sand 4-6 3335Gas Oil Total Depth 3352

PRODUCTION

1st 24 hrs. Nat. 1st 24 hrs. after shot Gas Cu. Ft.Dry Hole Abandoned

Date

DEC 13 1936

19

H. D. Hatfield Scout